

MISSISSIPPI DEPARTMENT OF NATURAL RESOURCES

Bureau of Land and Water Resources

Southport Mall

P.O. Box 10631

Jackson, Mississippi 39209

WATER WELL DRILLERS LOG

Wayne  
N 2045  
6-17-85

June 17 1985 Boyer Drilling & Log Itasca  
date well completed firm name county well located

LANDOWNER: Tom Hagen  
Box 25  
State Line Ms.  
(mailing address)


WELL LOCATION:  
sec. 24 T N R 7 E  
15 S Haynesboro  
miles of (distance) (direction) (nearest town)

WELL PURPOSE: Home  
(home, irrigation, municipal, industrial)

- WELL COMPLETION DATA:
- (1) diameter (inches) 2"
  - (2) total depth (feet) 101'
  - (3) static water level (feet) 11  below  above top of ground.
  - (4) casing P.V.C. 96'  
(material) (depth)  
2" if telescope see back.  
(size)
  - (5) screen 5' 96'  
(length) (depth to top)  
2" 8 scht. P.V.C.  
(size) (material)
  - (6) pump none set  
(HP) (yield gpm)  
elec  
(type power)
  - (7) electric log no  
(yes or no)  
MS  
(organization running log)
  - (8) how well bottom plugged 2 sand pack

description of formations encountered	from	to
<u>sand</u>	<u>0</u>	<u>6</u>
<u>blue clay</u>	<u>6</u>	<u>16</u>
<u>sand</u>	<u>16</u>	<u>24</u>
<u>clay</u>	<u>24</u>	<u>25</u>
<u>rock strata</u>	<u>25</u>	<u>28</u>
<u>clay</u>	<u>28</u>	<u>42</u>
<u>rock</u>	<u>42</u>	<u>44</u>
<u>clay</u>	<u>44</u>	<u>82</u>
<u>sandy siltstone on clay</u>	<u>82</u>	<u>101</u>

DRILLERS REMARKS:

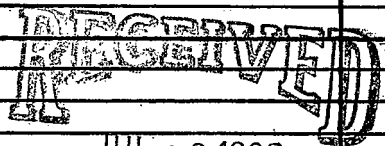


JUL 23 1985

Department of Natural Resources  
Bureau of Land & Water Resources

If well telescopes please sketch and show depths.

GROUND LEVEL

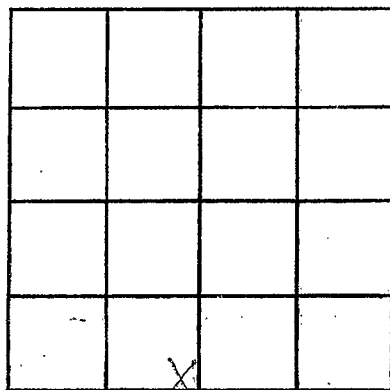

SECTION 24

Please indicate well location X.

ADDITIONAL INFORMATION

If more than one screen,  
show locations of each on sketch.