

MISSISSIPPI DEPARTMENT OF NATURAL RESOURCES

Bureau of Land and Water Resources

Southport Mall

P.O. Box 10631

Jackson, Mississippi 39209

WATER WELL DRILLERS LOG

Wayne
N 2047

Sept 12

1985

Robert Drilling & Log

Wayne

date well completed

firm name

county well located

LANDOWNER: Jimmy G. Clark
1105 Wilcox Dr.
Waynesboro, Me.
(mailing address)

description of formations encountered	from	to
sandy clay	0	28
red strata	28	32
clay	32	50
red strata	50	58
clay	58	73
sand	73	77
clay	77	134
thin sand some clay	134	150
clay	150	167
thin sand to clay	167	185
thin sand	185	189
thin clay thin sand	189	240
thin clay thin sand	240	253
thick sand		

WELL LOCATION:

sec. 25 T. 2 N. R. 7 E.
2 miles S of Waynesboro
(distance) (direction) (nearest town)

WELL PURPOSE: none
(home, irrigation, municipal, industrial)


WELL COMPLETION DATA:

- (1) diameter (inches) 2'
- (2) total depth (feet) 253'
- (3) static water level (feet) 10' below top of ground
- (4) casing PVC, 248' (depth)
2" if telescope see back. (size)
- (5) screen 5' (length), 248' (depth to top)
2" (size), Bell P.V.C. (material)
- (6) pump 1 (HP), 15 (yield gpm)
elec. (type power)
- (7) electric log no (yes or no)

(organization running log)

(8) how well bottom plugged
2" thick sand


DRILLERS REMARKS:

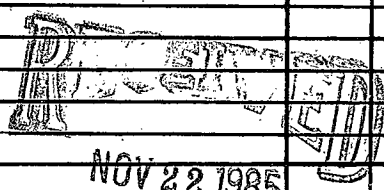

Department of Natural Resources
Bureau of Land & Water Resources

If well telescopes please sketch and show depths.

GROUND LEVEL

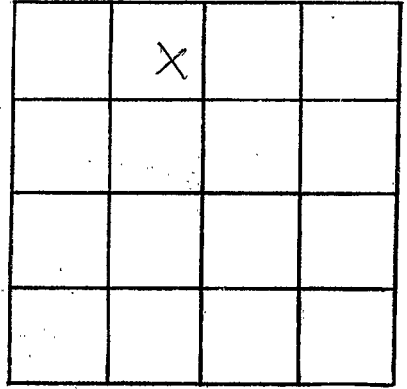

SECTION 25

Please indicate well location X.

ADDITIONAL INFORMATION

Lined area for additional information.

If more than one screen, show locations of each on sketch.