

MISSISSIPPI DEPARTMENT OF NATURAL RESOURCES

Bureau of Land and Water Resources

Southport Mall

P.O. Box 10631

Jackson, Mississippi 39209

WATER WELL DRILLERS LOG

WAYNE
N 2048

Oct 25 1995 (date well completed) Pro. Drillers, Inc. (firm name) Wayne (county well located)

LANDOWNER: John McMichael
At S. Haywood
(mailing address)

description of formations encountered	from	to
Clay sand	0	70
fine sand	70	75
thin sand, with gravel	75	81
silts, silt & clay		

WELL LOCATION:
sec. 6 T. 4 N. R. 7 E.
4 1/2 miles (distance) and Haywood (direction) of Haywood (nearest town)

22' 1" PVC drive pipe

WELL PURPOSE: Home
(home, irrigation, municipal, industrial)

WELL COMPLETION DATA:

- (1) diameter (inches) 2"
- (2) total depth (feet) 21'
- (3) static water level (feet) 66 below above top of ground.
- (4) casing PVC, 76' (material) (depth)
2" if telescope see back. (size)
- (5) screen 5' 76' (length) (depth to top)
2" Soft P.V.C. (size) (material)
- (6) pump 1 10 (HP) (yield gpm)
elec. (type power)
- (7) electric log no (yes or no)
(organization running log)
- (8) how well bottom plugged 2' packed with sand


DRILLERS REMARKS:

RECEIVED
NOV 22 1995

Department of Natural Resources
Bureau of Land & Water Resources

If well telescopes please sketch and show depths.

GROUND LEVEL

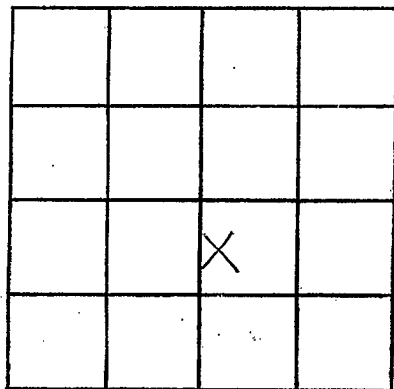

SECTION 6

Please indicate well location X.

ADDITIONAL INFORMATION

If more than one screen,
show locations of each on sketch.