

MISSISSIPPI DEPARTMENT OF NATURAL RESOURCES

Bureau of Land and Water Resources

Southport Mall

P.O. Box 10631

Jackson, Mississippi 39209

WATER WELL DRILLERS LOG

WAYNE
N 200A

Mar 26 1986 date well completed
36 Drilling & Log firm name
Itzinger county well located


LANDOWNER: John H. Hart
P.O. Box 5, Itzinger, Ms.
(mailing address)

WELL LOCATION:
sec 10 T 8 N R 7 E
S W
2 miles (distance) west (direction) of Itzinger (nearest town)

WELL PURPOSE: Home
(home, irrigation, municipal, industrial)

- WELL COMPLETION DATA:
- (1) diameter (inches) 2
 - (2) total depth (feet) 150
 - (3) static water level (feet) 40 below top of ground
 - (4) casing (material) steel (depth) 120'
2" if telescope see back. (size)
 - (5) screen none (length) (depth to top)
 - (6) pump 1 (HP) 15 (yield gpm)
elec. (type power)
 - (7) electric log no (yes or no)
(organization running log)
 - (8) how well bottom plugged open

description of formations encountered	from	to
clay	0	28
red sandstone	28	72
clay	72	120
shale	120	150
6.3' 1 1/2" grade clay zone		

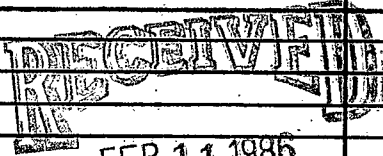


FEB 11 1986

Department of Natural Resources
Bureau of Land & Water Resources

DRILLERS REMARKS:

If well telescopes please sketch and show depths.

GROUND LEVEL

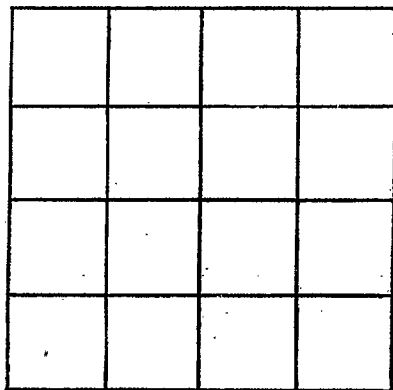

SECTION _____

Please indicate well location X.

ADDITIONAL INFORMATION

If more than one screen,
show locations of each on sketch.