

MISSISSIPPI DEPARTMENT OF NATURAL RESOURCES

Bureau of Land and Water Resources

Southport Mall

P.O. Box 10631

Jackson, Mississippi 39209

WATER WELL DRILLERS LOG

WAYNE  
N 2050

May 29 1986 19 Carter Drilling & Log Wayne county well located

LANDOWNER: Jimmy Walker  
At 1 2 Wayne Blvd, MS  
(mailing address)

description of formations encountered	from	to
clay	0	13
blue sand	13	17
rock strata	17	35
clay	35	81
interbedded rock	81	120


WELL LOCATION:  
sec 3 T 8 N R 7 E  
2 miles NW of Hattiesburg  
(distance) (direction) (nearest town)

WELL PURPOSE: Cattle Pond  
(home, irrigation, municipal, industrial)

105' 1 1/2" cycle down pipe

WELL COMPLETION DATA:

- (1) diameter (inches) 4"
- (2) total depth (feet) 120'
- (3) static water level (feet) 34' below top of ground.
- (4) casing (material) steel (depth) 81'
- 4" (size) if telescope see back.
- (5) screen none used (length) (depth to top)
- (size) (material)
- (6) pump 1 (HP) 23 (yield gpm)
- elec. (type power)
- (7) electric log no (yes or no)
- (organization running log)
- (8) how well bottom plugged open

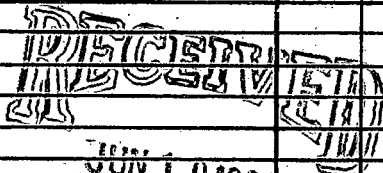


Department of Natural Resources  
Bureau of Land & Water Resources

DRILLERS' REMARKS:

If well telescopes please sketch and show depths.

GROUND LEVEL

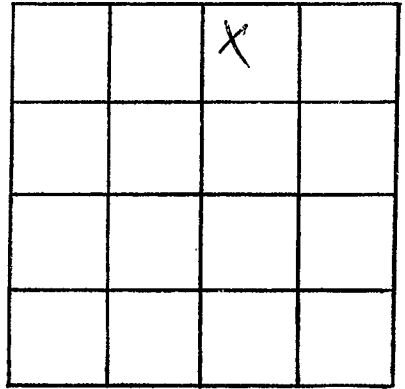

SECTION 3

Please indicate well location X.

ADDITIONAL INFORMATION

If more than one screen,  
show locations of each on sketch.