

WAYNE  
N 2051

MISSISSIPPI  
BOARD OF WATER COMMISSIONERS  
416 North State Street  
Jackson, Mississippi 39201

WATER WELL DRILLERS LOG

1986 CARRS Well SERV WAYNE  
date well completed firm name county well located


LANDOWNER:	description of formations encountered	from	to
Clyde Dobson	SAND	0	16
BUCKAYUNNA TAS (mailing address)	med white SAND	16	22
WELL LOCATION: 24 sec. T-8 N S R-7 E W 1 miles South of Wab0 (distance) (direction) (nearest town)	Blue CLAY	22	34
WELL PURPOSE: SAW MILL (home, irrigation, municipal, industrial)	Lime Rock	34	35
WELL COMPLETION DATA:	GRAY CLAY	35	37 1/2
(1) diameter (inches) 3"	Lime Rock	37 1/2	38
(2) total depth (feet) 85	GRAY CLAY	38	39
(3) static water level (feet) 21 below top of ground.	Lime Rock	39	39 1/2
(4) casing PVC 80 (material) (depth)	GRAY CLAY	39 1/2	52
(size) if telescope see back.	med Lime Rock	52	53
(5) screen 10' 7.5 (length) (depth to top)	GRAY CLAY	53	56
2" PVC (size) (material)	HARD Lime Rock	56	58 1/2
(6) pump 1 (HP) 12 (yield gpm)	SOFT Lime	58 1/2	59
Elect. (type power)	HARD Lime Rock	59	59 1/2
(7) electric log NO (yes or no)	med Lime Rock	59 1/2	60 1/2
(organization running log)	HARD Lime Rock	60 1/2	61
(8) how well bottom plugged 2" CAP	med Lime Rock	61	62
DRILLERS REMARKS:	SOFT Lime	62	63
	HARD Lime Rock	63	64
	Fine GRAY SAND	64	80
	Med GRAY SAND	80	85

DEPARTMENT OF LAND AND WATER RESOURCES  
JUL 22 2006

Department of Land and Water Resources

If well telescopes please sketch and show depths.

GROUND LEVEL

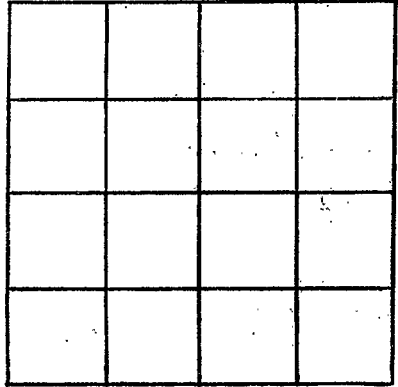

SECTION \_\_\_\_\_

Please indicate well location X.

ADDITIONAL INFORMATION

If more than one screen, show locations of each on sketch.