

MISSISSIPPI DEPARTMENT OF NATURAL RESOURCES

Bureau of Land and Water Resources

Southport Mall

P.O. Box 10631

Jackson, Mississippi 39209

WATER WELL DRILLERS LOG

WAYNE
N 2052

9/30 1986 CARB'S WELL SER WAYNE
date well completed firm name county well located

LANDOWNER: J.K. BEASLEY
RT. WAYNES BORO
MS. 39367
(mailing address)

WELL LOCATION:
sec. 17 T. 8 N R. 7 E
MAYNOR C&S RD. W
5 miles W of WAYNESBORO
(distance) (direction) (nearest town)

WELL PURPOSE: HOME
(home, irrigation, municipal, industrial)

- WELL COMPLETION DATA:
- (1) diameter (inches) 2"
 - (2) total depth (feet) 89
 - (3) static water level (feet) 32 below top of ground.
 - (4) casing 2" (material), 84 (depth)
2" (size) if telescope see back.
 - (5) screen 5' (length), 84 (depth to top)
2" (size), P.V.C. (material)
 - (6) pump 11 (HP), 7 (yield gpm)
ELEC. (type power)
 - (7) electric log NO (yes or no)
(organization running log)
 - (8) how well bottom plugged ~~SHADE~~ D BACK WASH

description of formations encountered	from	to
TOP SOIL	0	1
S.D. & CLAY	1	20
CLAY	20	66
S.D. & CLAY	66	73
CLAY	73	75
S.D.	75	84

STOPPED ON CHAIRS

RECEIVED


OCT 20 1986

Department of Natural Resources
Bureau of Land & Water Resources

DRILLERS REMARKS: VALVE WITH L.H. NEPPLE ON AIO THERMANS

If well telescopes please sketch and show depths.

GROUND LEVEL

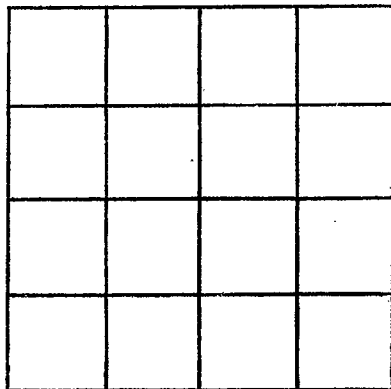

SECTION _____

Please indicate well location X.

ADDITIONAL INFORMATION

If more than one screen,
show locations of each on sketch.