

MISSISSIPPI DEPARTMENT OF NATURAL RESOURCES

Bureau of Land and Water Resources

Southport Mall

P.O. Box 10631

Jackson, Mississippi 39209

WATER WELL DRILLERS LOG

WAYNE
N 2053

10/22 1986
date well completed

CARB'S WELL CO.
firm name

WAYNE
county well located

LANDOWNER: PUGUS DAVIS
PT. 5 MANOR CREEK RD.
WAYNESBORO, MS 39367
(mailing address)

description of formations encountered	from	to
TOP SOIL	0	1
MED. SD. SOME R.K.	1	19
SAND	19	65
ROCK	65	67

WELL LOCATION:
sec. 30 T 8 N R 7 E
S W
5 miles SW of WAYNESBORO
(distance) (direction) (nearest town)

WELL PURPOSE:
(home, irrigation, municipal, industrial)

- WELL COMPLETION DATA:
- (1) diameter (inches) 2"
 - (2) total depth (feet) 67'
 - (3) static water level (feet) 34 (below/above top of ground)
 - (4) casing (material) PVC, (depth) 57'
2" (size) if telescope see back.
 - (5) screen (length) 10', (depth to top) 57'
2" (size), PVC (material)
 - (6) pump 1 (HP), (yield gpm) _____
ELEC. (type power)
 - (7) electric log NO (yes or no)
 - (organization running log) _____
 - (8) how well bottom plugged B.W.V. PROSSED WITH LITH NIPPIC

RECEIVED


NOV 13 1986

Department of Natural Resources
Bureau of Land & Water Resources

DRILLERS REMARKS:

If well telescopes please
sketch and show depths.

GROUND LEVEL

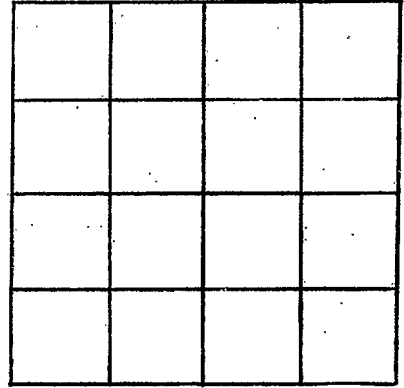

SECTION _____

Please indicate well location X.

ADDITIONAL INFORMATION

If more than one screen,
show locations of each on sketch.