

MISSISSIPPI DEPARTMENT OF NATURAL RESOURCES

Bureau of Land and Water Resources

COUNTY WELL LOCATED WAYNE	
WELL NUMBER N	CODED
DATE WELL COMPLETED 6/8/87	

PERMIT NUMBER
NAME OF DRILLING FIRM CAR

P.O. Box 10631
Jackson, Mississippi 39209
WATER WELL DRILLERS LOG

NAME & MAILING ADDRESS OF LANDOWNER JAMES WAITER'S		
BT. 3		
WAYNESBORO, MS.		
WELL LOCATION: SEC	TOWNSHIP	RANGE
19	8	7
DISTANCE	DIRECTION	NEAREST TOWN
Miles 3	S	SOUTH
OTHER LANDMARK WAYNESBORO ON CHICKASAW RIVER		
WELL PURPOSE: Home, Irrigation, Municipal, Industrial, Fish Pond, etc. HOME		

PUMP DATA		
PUMP TYPE (Circle One): Submersible, Turbine, Jet Flowing Well, Other (Describe) _____		
POWER TYPE (Circle One): Electric Tractor, Diesel, Gasoline, Butane, Other (Describe) _____		
Pump Capacity (GPM) 10	No. of Stages 1	Setting Depth 25 FT.
PUMP TEST		
Well yielded 10 GPM with a drawdown of 3 ft. after 2 hours of pumping		

WELL DATA		
Well Depth 98'	Casing Diameter (In.) 2''	Casing Length (Ft.) 93
Type of Casing PVC	Hole Depth 98	Depth to Static Water Level 4'
TYPE OF COMPLETION: (Circle One or More): Gravel Packed, Underreamed, Telescoped, Natural Development , Open Hole, Other (Describe) SAND PACKED		
Top of Lap Pipe or Reduction in Casing FEET IF TELESKOPED OR MORE THAN ONE SCREEN: USE BACK PAGE		

LOG DATA	
TYPE OF LOG RUN (Circle One): No Log Run, Electric, Gamma Ray, Density, Sonic, Neutron, Other (Describe) _____	
Name of Organization Running Log	


SCREEN DATA		
Diameter - Inches 2''	Length - Feet 5'	Slot Size - Inches 6
Screen Type PVC	Depth to Bottom - Feet 98	

GEOLOGIC DATA (Office Use Only)			
Surface Elev.	Geologic Unit	Unit Thickness	Depth to Top
Subs. SWL	Date	Analysis	Aquifer Test

Driller's Remarks

DESCRIPTION OF FORMATIONS ENCOUNTERED	FROM	TO
CLAY	0	11
SD. & CLAY	11	26
BLUE CLAY	26	30
FINE WH. SD. & CLAY	30	36
BLUE CLAY	36	39
ROCK STRATOR	39	79
SD. & CLAY	79	88
MED. SD. & CLAY	88	94
CHALK	94	98

FORMATIONS (Continued)	FROM	TO

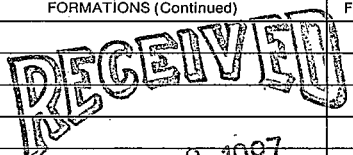


JUL 2 1987

Department of Natural Resources
Bureau of Land & Water Resources

IF MORE SPACE IS NEEDED, USE BACK

If well telescopes please
sketch and show depths.

GROUND LEVEL

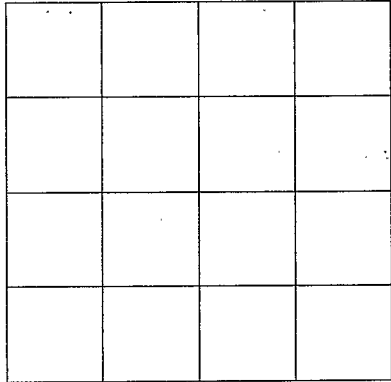

SECTION _____

Please indicate well location X.

ADDITIONAL INFORMATION

If more than one screen,
show location of each on sketch.