

MISSISSIPPI DEPARTMENT OF ENVIRONMENTAL QUALITY
Bureau of Land and Water Resources

P. O. Box 10631
Jackson, MS 39289-0631
WATER WELL DRILLERS LOG

COUNTY WELL LOCATED WAYNE	
WELL NUMBER N	CODED
DATE WELL COMPLETED 8-9-93	

PERMIT NUMBER 0-205
NAME OF DRILLING FIRM CARRS well SERV

NAME & MAILING ADDRESS OF LANDOWNER Clyde Dobson		
Delta DR		
Waynesboro MS		
WELL LOCATION: SEC	TOWNSHIP	RANGE
24	8 S	7 E
DISTANCE	DIRECTION	NEAREST TOWN
1 1/2 Miles	South	WABO
OTHER LANDMARK PASS AIRPORT LEFT		
WELL PURPOSE: Home, Irrigation, Municipal, Industrial, Fish Pond, etc. Home		

PUMP DATA		
PUMP TYPE (Circle One): Submersible, Turbine, Jet, Flowing Well, Other (Describe)		
POWER TYPE (Circle One): <u>Electric</u> , Tractor, Diesel, Gasoline, Butane, Other (Describe) H/P 1		
Pump Capacity (GPM) 10	No. of Stages 2	Setting Depth 40 FT.
PUMP TEST		
Well yielded 25 GPM with a drawdown of 0 ft. after 1 hours of pumping		

WELL DATA		
Well Depth 85	Casing Diameter (In.) 2	Casing Length (Ft.) 75
Type of Casing PVC	Hole Depth 85	Depth to Static Water Level 14
TYPE OF COMPLETION: (Circle One or More): Gravel Packed, Underreamed, Telescoped, Natural Development, Open Hole, Other (Describe) <u>Natural Development</u>		
Top of Lap Pipe or Reduction in Casing FEET IF TELESCOPED OR MORE THAN ONE SCREEN: USE BACK PAGE		

LOG DATA	
TYPE OF LOG RUN (Circle One): No Log Run, Electric, Gamma Ray, Density, Sonic, Neutron, Other (Describe)	
Name of Organization Running Log	

SCREEN DATA		
Diameter - Inches 2	Length - Feet 10	Slot Size - Inches 65/100
Screen Type PVC WRAPPED	Depth to Bottom - Feet 85	


GEOLOGIC DATA (Office Use Only)			
Surface Elev.	Geologic Unit	Unit Thickness	Depth to Top
Subs. SWL	Date	Analysis	Adult Test
Driller's Remarks OCT 08 1993			
Dept. of Environmental Quality Office of Land & Water Resources			

DESCRIPTION OF FORMATIONS ENCOUNTERED	FROM	TO	FORMATIONS (Continued)	FROM	TO
TOP SOIL	0	1	SOFT ROCK + CLAY	52	57
COARSE SD & GVL	1	16	HD LIME ROCK	57	59
YELLOW CLAY	16	20	GRAY CLAY	59	63
BLUE CLAY	20	24	FINE & MED. SD	63	80
ROCK	24	25	FINE GRAY SD	80	85
BLUE CLAY	25	28			
ROCK	28	29			
GRAY CLAY	29	45			
ROCK	45	46			
GRAY CLAY	46	51			
HD LIME ROCK	51	52			

IF MORE SPACE IS NEEDED, USE BACK

If well telescopes please
sketch and show depths.

GROUND LEVEL

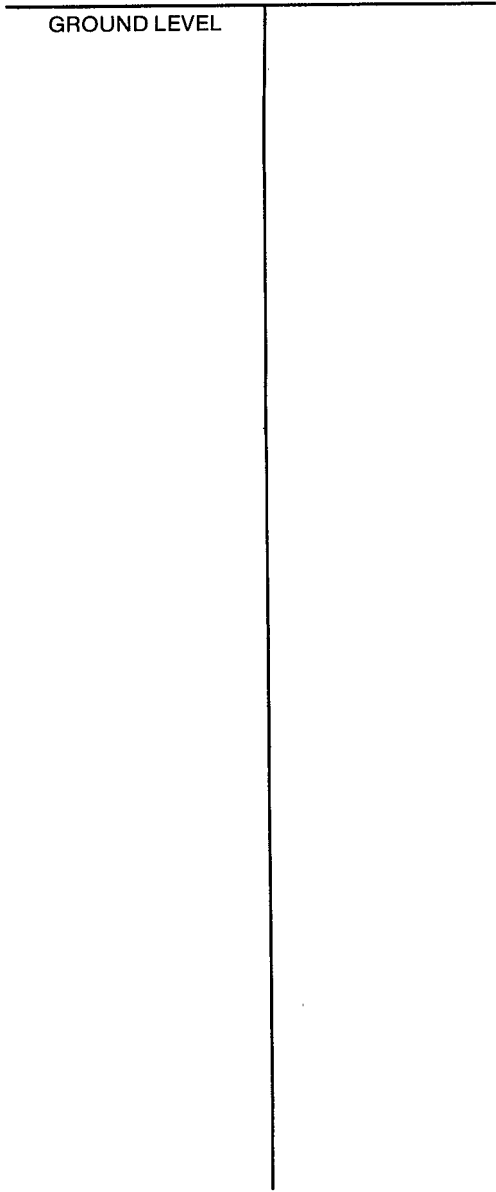

If more than one screen,
show location of each on sketch.

SECTION _____

Please indicate well location X.

ADDITIONAL INFORMATION

