

10

4-22-64

WATER WELL DRILLERS LOG

Date April 22, 1964, Driller: Porter Drilling & Log County Wayne
 (Name)


(1) Owner of Land: Whiley Humphrey
 (Name)
Rt 4 Waynesboro, Miss
 (Address)
 (2) Location: NE 1/4, SW 1/4, Sec. 35 T8R6
5 miles SE of Waynesboro
 (distance) (direction) (Nearest Town)
 (3) Topography: flat
 (Hilly) (Flat) (Level)
 (4) Purpose of Well: domestic
 (Domestic Irrigation
 Municipal, Industrial, Other)

Description & Color of Materials Sand, Clay, Red Clay, Shell, etc.	Thick- ness Feet	Depth Feet
<u>red clay</u>	<u>16</u>	<u>16</u>
<u>red sand</u>	<u>14</u>	<u>30</u>
<u>sand & chalk</u>	<u>8</u>	<u>38</u>
<u>hard chalk</u>	<u>17</u>	<u>55</u>
<u>soft chalk & fine sand</u>	<u>11</u>	<u>66</u>
<u>chalk</u>	<u>6</u>	<u>72</u>
<u>fine sand & chalk</u>	<u>14</u>	<u>86</u>
<u>course sand</u>	<u>24</u>	<u>110</u>
<u>striped or sand</u>		
<u>mixed with some chalk</u>		

Information upon completion of well:

(1) Diameter 2" inches.
 (2) Total Depth 110' feet.
 (3) Water Level 87' feet below top of ground.
 (4) Cased to 105', Size 2"
 (5) Screen: Size 1 1/4", Length 5'
Johnson S.S.
 (6) Were any formations sealed against pollution?
 _____ yes, X no.

If YES depth of formation _____
 Why _____
 Drillers Remarks: _____

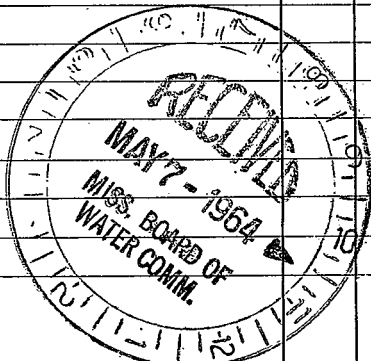

(Use Back Side)

Well No.

