

WAYNE MISSISSIPPI BOARD OF WATER COMMISSIONERS

012

2-25-64

WATER WELL DRILLERS LOG

Date: Feb 25, 1964, Driller: Benton Drilling & Sup Co County Wayne
 (Name)

(1) Owner of Land: Renwood Clark
 (Name)
Waynesboro Miss
 (Address)

(2) Location: NE 1/4, SE 1/4, Sec. 18 T8 R6,
1 miles S.E. of Waynesboro,
 (distance) (direction) (Nearest Town)

(3) Topography: flat
 (Hilly) (Flat) (Level)

(4) Purpose of Well: domestic
 (Domestic Irrigation
 Municipal, Industrial, Other)

Description & Color of Materials Sand, Clay, Red Clay, Shell, etc.	Thick- ness Feet	Depth Feet
<u>clay</u>	<u>8</u>	<u>8</u>
<u>chalk</u>	<u>6</u>	<u>14</u>
<u>sand</u>	<u>10</u>	<u>24</u>
<u>blue chalk</u>	<u>7</u>	<u>31</u>
<u>strata of rock</u>	<u>11</u>	<u>42</u>
<u>blue chalk</u>	<u>4</u>	<u>46</u>
<u>rock</u>	<u>1</u>	<u>47</u>
<u>blue chalk</u>	<u>11</u>	<u>58</u>
<u>strata of rock</u>	<u>16</u>	<u>74</u>
<u>brown chalk</u>	<u>20</u>	<u>94</u>
<u>overt sand</u>	<u>8</u>	<u>102</u>
<u>stopped on chalk</u>		

Information upon completion of well:

(1) Diameter 2" inches.

(2) Total Depth 102' feet.

(3) Water Level 31 feet below top of ground.


(4) Cased to 94', Size 2"

(5) Screen: Size 1 1/4", Length 6'
80 ga

(6) Were any formations sealed against pollution?
 _____ yes, X no.

If YES depth of formation _____
 Why _____

Drillers Remarks: _____

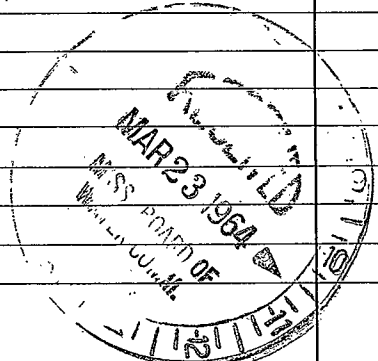

(Use Back Side)

Well No.

