

WAYNE
013
11-12-63

WATER WELL DRILLERS LOG

Date: Nov 12, 1963, Driller: Porter Drilling & Pump Co. Wayne
(Name)

- (1) Owner of Land: Reynold Clark
(Name)
Waynesboro Miss.
(Address)
- (2) Location: NE 1/4, SE 1/4, Sec. 18 T8 R6,
1/2 miles SE, of Waynesboro,
(distance) (direction) (Nearest Town)
- (3) Topography: level
(Hilly) (Flat) (Level)
- (4) Purpose of Well: domestic
(Domestic Irrigation
Municipal, Industrial, Other)

Description & Color of Materials Sand, Clay, Red Clay, Shell, etc.	Thick- ness Feet	Depth Feet
<u>top soil</u>	<u>3</u>	<u>3</u>
<u>chalk</u>	<u>9</u>	<u>12</u>
<u>sand</u>	<u>7</u>	<u>19</u>
<u>blue chalk</u>	<u>11</u>	<u>30</u>
<u>rock</u>	<u>8</u>	<u>38</u>
<u>blue chalk</u>	<u>18</u>	<u>56</u>
<u>rock</u>	<u>1</u>	<u>77</u>
<u>chalk</u>	<u>3</u>	<u>76</u>
<u>sand & chalk streak</u>	<u>21</u>	<u>97</u>
<u>chalk</u>	<u>1 1/2</u>	<u>98 1/2</u>
<u>sand</u>	<u>4 1/2</u>	<u>103</u>
<u>chalk</u>	<u>2</u>	<u>105</u>


Information upon completion of well:

- (1) Diameter 2" inches.
- (2) Total Depth 105' feet.
- (3) Water Level 34' feet below top of ground.
- (4) Cased to 97', Size 2"
- (5) Screen: Size 1 1/4", Length 6'
- (6) Were any formations sealed against pollution?
no

If YES depth of formation _____

Why _____

Drillers Remarks: _____

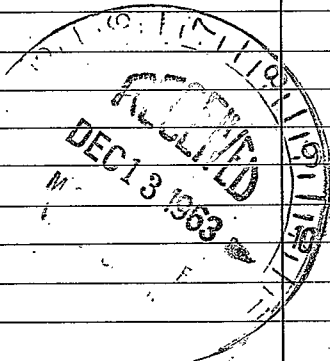

(Use Back Side)

Well No.

