

018
3-11-64

WATER WELL DRILLERS LOG

17

Date: March 11, 1964, Driller: Porter Drilling & Pump County: Wayne
(Name)

(1) Owner of Land: Reynolds Clark
(Name)
Haynesboro Miss
(Address)

(2) Location: NE 1/4, SE 1/4, Sec. 18 T 8 R 6
1 miles SE of Haynesboro
(distance) (direction) (Nearest Town)

(3) Topography: flat
(Hilly) (Flat) (Level)

(4) Purpose of Well: domestic
(Domestic Irrigation
Municipal, Industrial, Other)

Description & Color of Materials Sand, Clay, Red Clay, Shell, etc.	Thick- ness Feet	Depth Feet
clay	8	8
chalk	5	13
fine sand	5	18
chalk	6	24
blue chalk	8	32
strata of rock	9	41
blue chalk	17	58
strata of rock	19	77
blue chalk	2	79
met sand & g	14	93
stopped while		
still in sand		

Information upon completion of well:

(1) Diameter: 2" inches.

(2) Total Depth: 93' feet.

(3) Water Level: 39' feet below top of ground.

(4) Cased to: 86', Size 2"


(5) Screen: Size 1 1/4", Length 6'
80 ga

(6) Were any formations sealed against pollution?
no

If YES depth of formation _____

Why _____

Drillers Remarks: _____

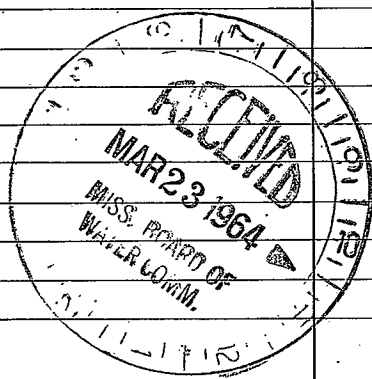

(Use Back Side)

Well No.

