

021

8-13-63

WATER WELL DRILLERS LOG

Date: Aug 13, 1963, Driller: Porter Drilling & Lp County Wayne
 (Name)

(1) Owner of Land: Ellis Moore
 (Name)
Rt 4 Waynesboro
 (Address)

(2) Location: SE 1/4, NE 1/4, Sec. 18 T8 R6,
1/2 miles SE of Waynesboro
 (distance) (direction) (Nearest Town)

(3) Topography: level
 (Hilly) (Flat) (Level)

(4) Purpose of Well: domestic
 (Domestic Irrigation
 Municipal, Industrial, Other)

Description & Color of Materials Sand, Clay, Red Clay, Shell, etc.	Thick- ness Feet	Depth Feet
<u>yellow clay</u>	<u>15</u>	<u>15</u>
<u>white sand</u>	<u>26</u>	<u>41</u>
<u>stopped on sand</u>		

Information upon completion of well:

(1) Diameter 2" inches.

(2) Total Depth 41' feet.

(3) Water Level 23 1/2' feet below top of ground.


(4) Cased to 35', Size 2"

(5) Screen: Size 1 1/4", Length 6'

(6) Were any formations sealed against pollution?
 yes, X no.

If YES depth of formation _____
 Why _____

Drillers Remarks: _____

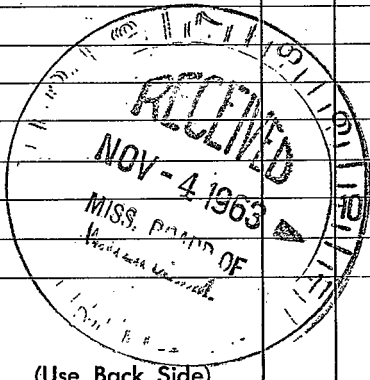

(Use Back Side)

Well No. _____

[The page contains extremely faint and illegible text, likely bleed-through from the reverse side of the document. No specific words or phrases can be discerned.]