

024

5-24-63

WATER WELL DRILLERS LOG

Date: May 24, 1963, Driller: Patrol Drilling & Log County Wayne
 (Name)

(1) Owner of Land: Argie Smith
 (Name)
Box 4 Nagsboro
 (Address)

(2) Location: SW 1/4, NE 1/4, Sec. 18 T8R6,
1/2 miles SE, of Nagsboro
 (distance) (direction) (Nearest Town)

(3) Topography: level
 (Hilly) (Flat) (Level)

(4) Purpose of Well: domestic
 (Domestic Irrigation
 Municipal, Industrial, Other)

Description & Color of Materials Sand, Clay, Red Clay, Shell, etc.	Thick- ness Feet	Depth Feet
<u>red clay</u>	<u>8</u>	<u>8</u>
<u>sand</u>	<u>4</u>	<u>12</u>
<u>blue looze chalk</u>	<u>11</u>	<u>23</u>
<u>sand</u>	<u>16</u>	<u>39</u>
<u>stayed while steel in sand</u>		

Information upon completion of well:

(1) Diameter 2 inches.


(2) Total Depth 39' feet.

(3) Water Level 15' feet below top of ground.

(4) Cased to 33', Size 2"

(5) Screen: Size 1 1/4, Length 6'

(6) Were any formations sealed against pollution?
 _____ yes, X no.

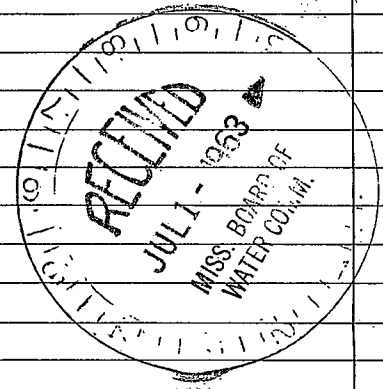

If YES depth of formation _____

Why _____

Drillers Remarks: _____

(Use Back Side)

Well No.

