

028

8-13-64

WATER WELL DRILLERS LOG

Date Aug 13, 1964, Driller: Porter Drilling Co County Wayne  
 (Name)

(1) Owner of Land: Mrs Fanny Jones  
 (Name)  
At 2 Waynesboro Miss  
 (Address)  
 (2) Location: SE 1/4, NW 1/4, Sec. 5 T8 R6  
3 miles NE of Waynesboro  
 (distance) (direction) (Nearest Town)  
 (3) Topography: Hilly  
 (Hilly) (Flat) (Level)  
 (4) Purpose of Well: domestic  
 (Domestic Irrigation  
 Municipal, Industrial, Other)


Description & Color of Materials Sand, Clay, Red Clay, Shell, etc.	Thick- ness Feet	Depth Feet
<u>red clay</u>	<u>10</u>	<u>10</u>
<u>fine red sand</u>	<u>30</u>	<u>40</u>
<u>sandy sand</u>	<u>4</u>	<u>44</u>
<u>white med. coarse sand</u>	<u>9</u>	<u>53</u>
<u>Coarse sand mixed with lignite chalk</u>	<u>4</u>	<u>57</u>
<u>stopped on rock</u>		<u>57</u>

Information upon completion of well:

(1) Diameter 2" inches.  
 (2) Total Depth 53' feet.  
 (3) Water Level 30' feet below top of ground.  
 (4) Cased to 47', Size 2"  
 (5) Screen: Size 1 1/4, Length 6'  
60 ga  
 (6) Were any formations sealed against pollution?  
no yes, X no.

If YES depth of formation \_\_\_\_\_  
 Why \_\_\_\_\_

Drillers Remarks: \_\_\_\_\_  
 \_\_\_\_\_  
 \_\_\_\_\_

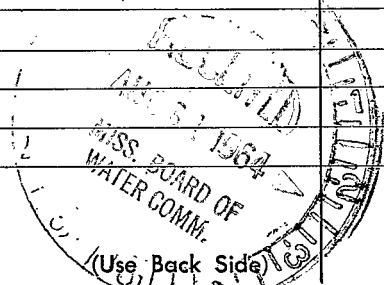

Well No. \_\_\_\_\_

