

Wayne
031
3-67

MISSISSIPPI
BOARD OF WATER COMMISSIONERS
416 North State Street
Jackson, Mississippi 39201

WATER WELL DRILLERS LOG

March 11 1967 Porter Drilling Co Wayne
date well completed firm name county well located

LANDOWNER: Babe Daws
Waynesboro, Miss

description of formations encountered

from to

sand	0	20
chalk	20	32
sand	32	52
chalk	52	69
sand	69	72
blue chalk	72	100
red shale	100	136
blue chalk	136	152
sand & shale	152	155
Vicksburg loam	155	184

(mailing address)


WELL LOCATION:
sec. 5 T 8 N R 6 E
S W
3 miles NE of Waynesboro
(distance) (direction) (nearest town)

WELL PURPOSE: home & farm
(home, irrigation, municipal, industrial)

WELL COMPLETION DATA:

- (1) diameter (inches) 4"
- (2) total depth (feet) 184'
- (3) static water level (feet) 120 below top of ground.
- (4) casing galv steel, 155'
(material) (depth)
4" if telescope see back.
(size)
- (5) screen none used
(length) (depth to top)
(size) (material)
- (6) pump 1 1/2 20
(HP) (yield gpm)
elec.
(type power)
- (7) electric log no
(yes or no)
(organization running log)
- (8) how well bottom plugged open ended

DRILLERS REMARKS:

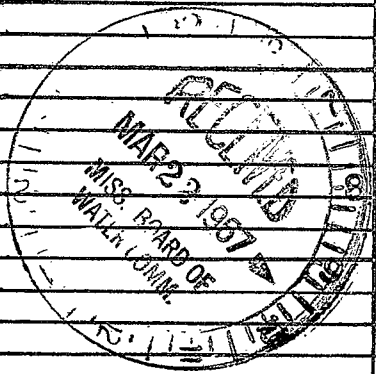

If well telescopes please sketch and show depths.

GROUND LEVEL

		X	

SECTION 5

Please indicate well location X.

ADDITIONAL INFORMATION

If more than one screen,
show locations of each on sketch.