

WAYNE MISSISSIPPI BOARD OF WATER COMMISSIONERS

032

4-27-61

WATER WELL DRILLERS LOG

0-303


Date April 27, 1961, Driller: D. N. Porter Co. Wayne
(Name)

(1) Owner of Land: <u>J. C. Gruber</u> <small>(Name)</small>	Description & Color of Materials Sand, Clay, Red Clay, Shell, etc.	Thick- ness Feet	Depth Feet
<u>At 2 Haynesboro, Miss</u> <small>(Address)</small>	<u>Clay</u> <u>chert & sand</u> <u>sand</u>	<u>15'</u> <u>60</u> <u>8'</u>	<u>15'</u> <u>75'</u> <u>83'</u>
(2) Location: <u>NW 1/4, NW 1/4, Sec. 5 T. 8 R. 6</u> <u>2 miles east</u> of <u>Haynesboro</u> <small>(distance) (direction) (Nearest Town)</small>			
(3) Topography: <u>hilly</u> <small>(Hilly) (Flat) (Level)</small>			
(4) Purpose of Well: <u>domestic</u> <small>(Domestic Irrigation, Municipal, Industrial, Other)</small>			

Information upon completion of well:

- (1) Diameter 2" inches.
- (2) Total Depth 83' feet.
- (3) Water Level 47' feet below top of ground.
- (4) Cased to 77', Size 2"
- (5) Screen: Size 1 1/4", Length 6'
- (6) Were any formations sealed against pollution?
 yes, no.

If YES depth of formation _____
 Why _____
 Drillers Remarks: _____

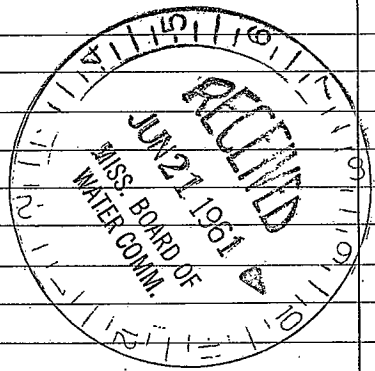

(Use Back Side)

Well No.

