

034

12-3-64

WATER WELL DRILLERS LOG

Date: Dec 3, 1964, Driller: Porter Drilling Co. County: Wayne

(Name)

(1) Owner of Land: home Roland Clark (Name)

Waynesboro Miss. (Address)

(2) Location: NW 1/4, NE 1/4, Sec. 6 T8R6, 1 miles NE of Waynesboro (distance) (direction) (Nearest Town)

(3) Topography: flat (Hilly) (Flat) (Level)

(4) Purpose of Well: domestic (Domestic Irrigation Municipal, Industrial, Other)

Description & Color of Materials Sand, Clay, Red Clay, Shell, etc.	Thick- ness Feet	Depth Feet
red clay	10	10
loose soft chalk	18	28
red sand	4	32
soft chalk	4	36
sand & some chalk	12	48
chalk	1	49

Information upon completion of well:

(1) Diameter 2 inches.

(2) Total Depth 49 feet.

(3) Water Level 18 feet below top of ground.

(4) Cased to 36, Size 2 copper


(5) Screen: Size 1 1/4, Length 8 Johnson S.S

(6) Were any formations sealed against pollution? yes, X no.

If YES depth of formation

Why

Drillers Remarks:

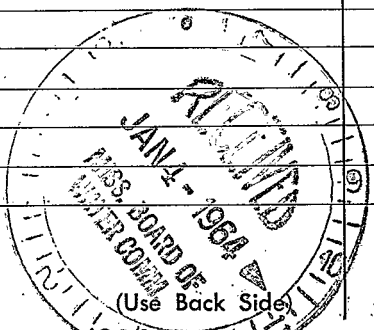

Well No.

