

# WAYNE MISSISSIPPI BOARD OF WATER COMMISSIONERS

036

## 3-31-65 WATER WELL DRILLERS LOG

Date: March 31, 1965, Driller: Porter Drilling Co County Wayne  
Grady Jones Sub. Div. well no 3 (Name)

(1) Owner of Land: Noland Clark  
(Name)

Waynesboro Miss  
(Address)

(2) Location NW 1/4, NE 1/4, Sec. 6 T8 R6

1 miles NE of Waynesboro  
(distance) (direction) (Nearest Town)

(3) Topography: flat  
(Hilly) (Flat) (Level)

(4) Purpose of Well: domestic  
(Domestic Irrigation, Municipal, Industrial, Other)

Description & Color of Materials Sand, Clay, Red Clay, Shell, etc.	Thick- ness Feet	Depth Feet
<u>red clay</u>	<u>5</u>	<u>5</u>
<u>chalk &amp; sand</u>	<u>12</u>	<u>17</u>
<u>red sand</u>	<u>9</u>	<u>26</u>
<u>white sand</u>	<u>6</u>	<u>32</u>


### Information upon completion of well:

- (1) Diameter 2" inches.
- (2) Total Depth 32' feet.
- (3) Water Level 13' feet below top of ground.
- (4) Cased to 29', Size 2"
- (5) Screen: Size 2", Length 4'  
plastic
- (6) Were any formations sealed against pollution?  
X no.

If YES depth of formation \_\_\_\_\_

Why \_\_\_\_\_

Drillers Remarks: \_\_\_\_\_  
 \_\_\_\_\_  
 \_\_\_\_\_  
 \_\_\_\_\_

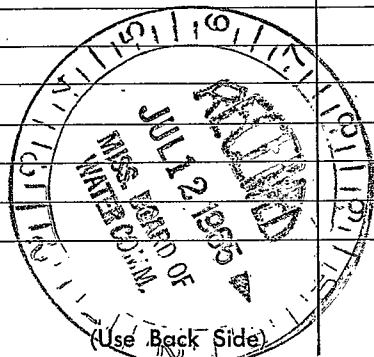

Well No.

