

WAYNE

MISSISSIPPI BOARD OF WATER COMMISSIONERS

037

3-4-62

WATER WELL DRILLERS LOG

Date: March 4, 1962, Driller: Porter Drilling & Exp. County: Wayne  
(Name)

|  |   |                        |               |
|--|---|------------------------|---------------|
| (1) Owner of Land: <u>Grady Jones</u><br>(Name)  | Description & Color of Materials<br>Sand, Clay, Red Clay, Shell, etc.         | Thick-<br>ness<br>Feet | Depth<br>Feet |
| <u>Lot 2 Nayseshoro</u><br>(Address)   | <u>red clay</u>   | <u>21</u>              | <u>21</u>     |
| (2) Location: <u>NW 1/4, NE 1/4, Sec. 6 T8R6</u><br><u>1</u> miles <u>NE</u> of <u>Nayseshoro</u><br>(distance) (direction) (Nearest Town) | <u>fine sand mixed<br/>with some chalk<br/>sand &amp; chalk on to<br/>40'</u> | <u>15</u>              | <u>36</u>     |
| (3) Topography: <u>hilly</u><br>(Hilly) (Flat) (Level)   |   |                        |               |
| (4) Purpose of Well: <u>domestic</u><br>(Domestic Irrigation<br>Municipal, Industrial, Other)  |   |                        |               |

Information upon completion of well:


- (1) Diameter 2' inches.
- (2) Total Depth 36' feet.
- (3) Water Level 12' feet below top of ground.
- (4) Cased to 32', Size 2''
- (5) Screen: Size 1/4', Length 4'
- (6) Were any formations sealed against pollution?  
no.

\_\_\_\_\_ yes, X no.

If YES depth of formation \_\_\_\_\_

Why \_\_\_\_\_

Drillers Remarks: \_\_\_\_\_

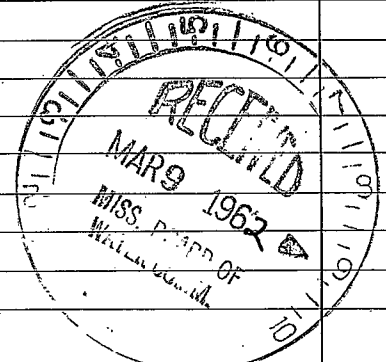

(Use Back Side)

Well No.

