

WAYNE

038

8-5-60

WATER WELL DRILLERS LOG

O-301

Date Aug 5, 1960, Driller: D. N. Porter & Son County Wayne

(Name)

(1) Owner of Land: Joyce Miller (Name)

Rt 2 Waynesboro, Miss. (Address)

(2) Location: 1/4, 1/4, Sec. 6 T8 R6,

1 miles N.E. of Waynesboro (distance) (direction) (Nearest Town)

(3) Topography: Flat (Hilly) (Flat) (Level)

(4) Purpose of Well: domestic (Domestic Irrigation Municipal, Industrial, Other)

Description & Color of Materials Sand, Clay, Red Clay, Shell, etc.

Thickness Feet

Depth Feet

clay 15 15 sand 15 30

Information upon completion of well:

(1) Diameter 2 inches.

(2) Total Depth 30 feet.

(3) Water Level 15 feet below top of ground.

(4) Cased to 24, Size 2

(5) Screen: Size 1 1/4, Length 6


(6) Were any formations sealed against pollution?

yes, X no.

If YES depth of formation

Why

Drillers Remarks:

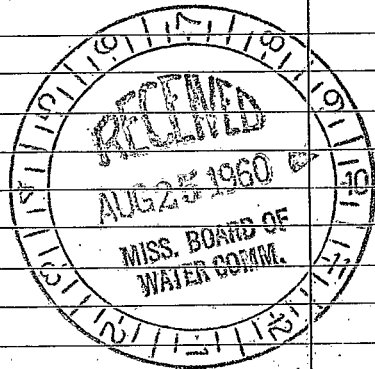

(Use Back Side)

Well No.

