

Wayne
039
11-67

MISSISSIPPI
BOARD OF WATER COMMISSIONERS
416 North State Street
Jackson, Mississippi 39201

WATER WELL DRILLERS LOG

Nov 1 1967 date well completed Port Drilling Corp firm name Wayne county well located

LANDOWNER: Robert Robinson
Cont. W. J. Wells
Earl H. Hub. Maynesboro
(mailing address)

description of formations encountered	from	to
rest clay	0	12
sand & clay	12	25
clay to some sand	25	40
sand	40	59

WELL LOCATION:
sec. 7 T 20 N R 6 E
S 4 W
1 miles east of Maynesboro
(distance) (direction) (nearest town)

stapert white steel
in sand

WELL PURPOSE: none
(home, irrigation, municipal, industrial)

WELL COMPLETION DATA:

(1) diameter (inches) 2"

(2) total depth (feet) 59'

(3) static water level (feet) 49' below top of ground.

(4) casing steel, 54' (material) (depth)
2" (size) If telescope see back.


(5) screen 5, 54 (length) (depth to top)
1/4, Galat Johnson S.S. (size) (material)

(6) pump 1, 10 (HP) (yield gpm)
elec (type power)

(7) electric log no (yes or no)
(organization running log)


(8) how well bottom plugged
plug point

DRILLERS REMARKS:

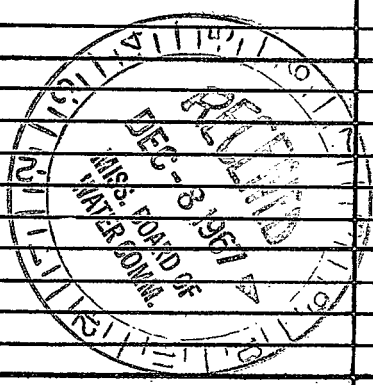

If well telescopes please sketch and show depths.

GROUND LEVEL

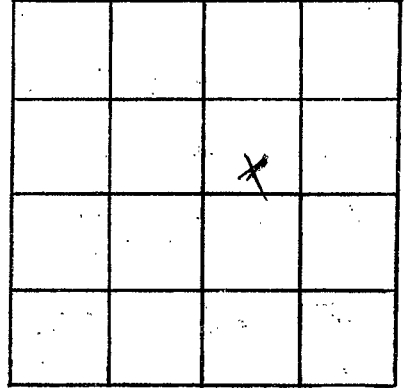

SECTION 7

Please indicate well location X.

ADDITIONAL INFORMATION

If more than one screen,
show locations of each on sketch.