

WAYNE MISSISSIPPI BOARD OF WATER COMMISSIONERS

040

3-10-66

WATER WELL DRILLERS LOG

Date: March 10, 1966, Drillers: Porter Drilling Co. County: Wayne  
 (Name)


(1) Owner of Land: Joye McElwain  
 (Name)  
At 2 Haysboro  
 (Address)  
 (2) Location: SW 1/4, NE 1/4, Sec. 7 T8 R6  
1 miles east of Haysboro  
 (distance) (direction) (Nearest Town)  
 (3) Topography: Hilly  
 (Hilly) (Flat) (Level)  
 (4) Purpose of Well: domestic  
 (Domestic Irrigation  
 Municipal, Industrial, Other)

Description & Color of Materials Sand, Clay, Red Clay, Shell, etc.	Thick- ness Feet	Depth Feet
red clay	12	12
course sand	6	18
red chalk	9	27
blue chalk	39	66
rock	2	68
blue chalk	4	72
rock	1	73
blue chalk	19	92
rock	2	94
blue chalk	11	105
rock strata	8	113
blue chalk	1	114
fine clean blue sand	31	145
fine blue sand mixed with some chalk	7	152
fine clean blue sand	7	159
blue chalk	14	173
limestone rock	30	203
white chalk	2	205

Information upon completion of well:

(1) Diameter 2" inches.  
 (2) Total Depth 205' feet.  
 (3) Water Level 86' feet below top of ground.  
 (4) Cased to 173', Size 2"  
 (5) Screen: Size none Length 3 1/2" bush to shell funnel on end of case  
 (6) Were any formations sealed against pollution?  
 \_\_\_\_\_ yes, X no.

If YES depth of formation \_\_\_\_\_  
 Why \_\_\_\_\_  
 Drillers Remarks: \_\_\_\_\_

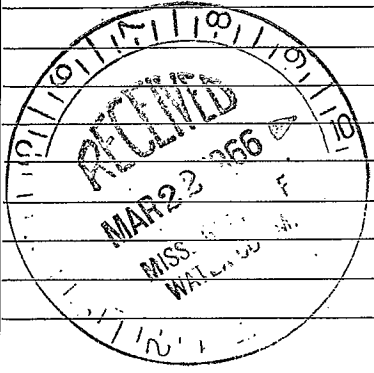

(Use Back Side)

Well No.

