

Wayne

042

10-67

MISSISSIPPI
 BOARD OF WATER COMMISSIONERS
 416 North State Street
 Jackson, Mississippi 39201

WATER WELL DRILLERS LOG

Oct 21 1967
date well completed

Porter Drilling & Imp
firm name

Wayne
county well located

LANDOWNER: Mrs R L

Land

description of formations encountered

from to

At 2 Magnolia Miss
(mailing address)

red clay 0 15
 red sand 15 35
 sand with some 35 48
 chalk mixed
 stopped on rock

WELL LOCATION:

sec. 8 T 8 N R 6 E
 S W
 2 miles east of Magnolia
 (distance) (direction) (nearest town)

WELL PURPOSE: home
(home, irrigation, municipal, industrial)

WELL COMPLETION DATA:


- (1) diameter (inches) 2"
- (2) total depth (feet) 46'
- (3) static water level (feet) 27' below top of ground.
- (4) casing steel, 40' (material) (depth)
2" (size) if telescope see back.
- (5) screen 6' length, 40' depth to top
1/4" 60ga brass jacket (size) (material)
- (6) pump 1/2 HP, 5 (yield gpm)
elec (type power)

(7) electric log no (yes or no)

(organization running log)


(8) how well bottom plugged flush joint

DRILLERS REMARKS:

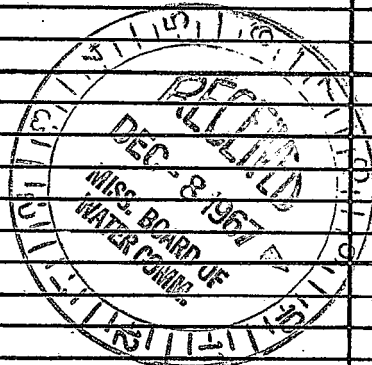

If well telescopes please sketch and show depths.

GROUND LEVEL

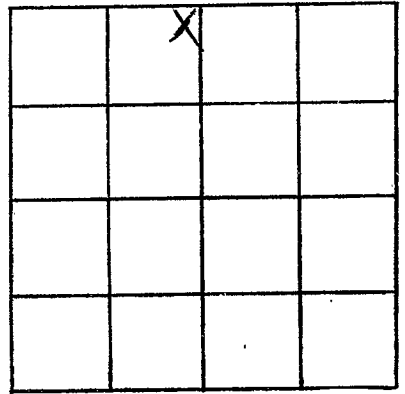

SECTION 2

Please indicate well location X.

ADDITIONAL INFORMATION

If more than one screen,
show locations of each on sketch.