

Wayne
043
9-67

MISSISSIPPI
BOARD OF WATER COMMISSIONERS
416 North State Street
Jackson, Mississippi 39201

WATER WELL DRILLERS LOG


SEPT 1967 Repa Dull Co. Wayne
date well completed firm name county well located

LANDOWNER: <u>EDDIE RICHIE</u>	description of formations encountered	from	to
<u>RT4</u>	<u>YELLOW SANDY CLAY & SAND STREAKS</u>	<u>0</u>	<u>30</u>
WAYNES BORO (mailing address)	<u>YELLOW SAND</u>	<u>30</u>	<u>48</u>
WELL LOCATION: sec <u>8</u> T <u>8N</u> S R <u>6E</u> W <u>2</u> miles <u>E</u> of <u>WARD</u> (distance) (direction) (nearest town)			
WELL PURPOSE: <u>HOME</u> (home, irrigation, municipal, industrial)			
WELL COMPLETION DATA:			
(1) diameter (inches) <u>2</u>			
(2) total depth (feet) <u>48</u>			
(3) static water level (feet) <u>32</u> below above top of ground.			
(4) casing <u>ALU</u> , <u>42'</u> (material) (depth)			
<u>2</u> if telescope see back. (size)			
(5) screen <u>6'</u> , <u>42'</u> (length) (depth to top)			
<u>2"</u> , <u>BRASS</u> (size) (material)			
(6) pump <u>1/2</u> , <u>3</u> (HP) (yield gpm)			
<u>ELECT</u> (type power)			
(7) electric log <u>NO</u> (yes or no)			
_____ (organization running log)			
(8) how well bottom plugged <u>BACK WASH VALVE</u>			
DRILLERS REMARKS:			



If well telescopes please sketch and show depths.

GROUND LEVEL

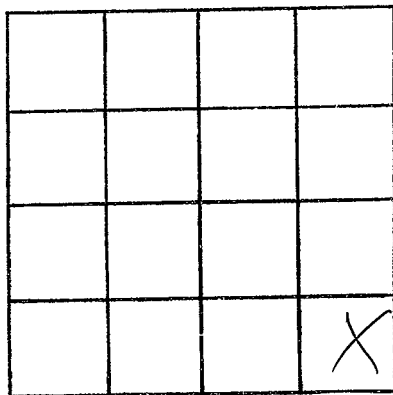

SECTION 8

Please indicate well location X.

ADDITIONAL INFORMATION

If more than one screen,
show locations of each on sketch.