


Wayne
044
9-67

MISSISSIPPI
BOARD OF WATER COMMISSIONERS
416 North State Street
Jackson, Mississippi 39201

WATER WELL DRILLERS LOG


SEPT 1967 Reple Dullin Co Wayne
date well completed firm name county well located

LANDOWNER:	description of fomations encountered	from	to
<u>Robert FROST</u> RT4 BOX 27-A	<u>YELLOW SANDY CLAY</u>	<u>0</u>	<u>35</u>
<u>WAYNESBORO</u> (mailing address)	<u>YELLOW SAND</u>	<u>35</u>	<u>50</u>
WELL LOCATION: sec. <u>8</u> T. <u>8</u> (N) R. <u>6</u> (E) <u>2</u> miles <u>E</u> of <u>WAYNESBORO</u> (distance) (direction) (nearest town)	<u>ROCK</u>	<u>50</u>	<u>51</u>
	<u>BLUE CLAY</u>	<u>51</u>	<u>108</u>
WELL PURPOSE: <u>Home</u> (home, irrigation, municipal, industrial)	<u>WHITE SAND</u>	<u>108</u>	<u>132</u>
WELL COMPLETION DATA:			
(1) diameter (inches) <u>2"</u>			
(2) total depth (feet) <u>132'</u>			
(3) static water level (feet) <u>75'</u> <u>below</u> top of ground.			
(4) casing <u>ALU</u> , <u>126'</u> (material) (depth) <u>2"</u> if telescope see back. (size)			
(5) screen <u>6'</u> , <u>126'</u> (length) (depth to top) <u>2"</u> , <u>BRASS</u> (size) (material)			
(6) pump <u>1/2</u> , <u>3</u> (HP) (yield gpm) <u>ELECT.</u> (type power)			
(7) electric log <u>NO</u> (yes or no) (organization running log)			
(8) how well bottom plugged <u>BACK</u> <u>WASH VACUE</u>			
DRILLERS REMARKS:			

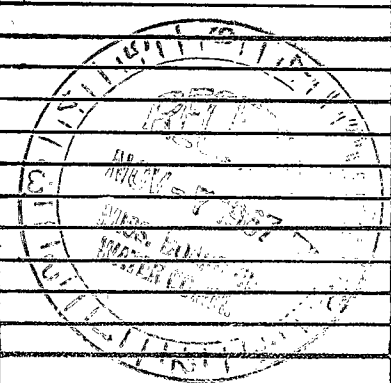

If well telescopes please sketch and show depths.

GROUND LEVEL

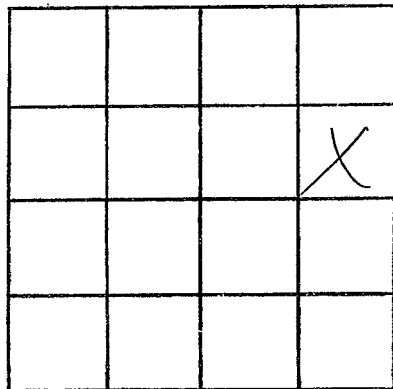

SECTION 8

Please indicate well location X.

ADDITIONAL INFORMATION

If more than one screen, show locations of each on sketch.