

045

3-19-65

WATER WELL DRILLERS LOG

Date: March 19, 1965, Driller: Port O'Kelly, Edge County, Wayne
(Name)

| (1) Owner of Land: <u>Mr. Verda Gray</u> (Name) | Description & Color of Materials Sand, Clay, Red Clay, Shell, etc. | Thick- ness Feet | Depth Feet |
|---|---|------------------------|---------------|
| <u>Rt 2 Waynesboro, Miss</u> (Address) | <u>red clay</u> | <u>8</u> | <u>8</u> |
| (2) Location: <u>NW 1/4, NW 1/4, Sec. 8 T8R6</u> | <u>sand</u> | <u>2</u> | <u>10</u> |
| <u>2</u> miles <u>east</u> of <u>Waynesboro</u> (distance) (direction) (Nearest Town) | <u>Chalk</u> | <u>7</u> | <u>17</u> |
| (3) Topography: <u>Hilly</u> (Hilly) (Flat) (Level) | <u>chalk & sand</u> | <u>39</u> | <u>56</u> |
| (4) Purpose of Well: <u>domestic</u> (Domestic Irrigation Municipal, Industrial, Other) | <u>fine sand</u> | <u>5</u> | <u>61</u> |
| | <u>hard to course sand</u> | <u>8</u> | <u>69</u> |


Information upon completion of well:

- (1) Diameter 2 inches.
- (2) Total Depth 69' feet.
- (3) Water Level 44' feet below top of ground.
- (4) Cased to 63', Size 2"
- (5) Screen: Size 1 1/4", Length 6'
60 ga
- (6) Were any formations sealed against pollution?
no

If YES depth of formation _____

Why _____

Drillers Remarks: _____

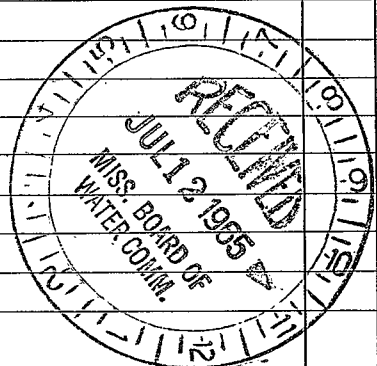

(Use Back Side)

Well No.

