

WAYNE
046

MISSISSIPPI BOARD OF WATER COMMISSIONERS

7-29-66

WATER WELL DRILLERS LOG

Date: July 29, 1966, Drilled by Porter Drilling & Log County Wayne
(Name)

(1) Owner of Land: Robert Mc Shain
(Name)
Rt 2 Waynesboro
(Address)

(2) Location: NW 1/4, NW 1/4, Sec. 9 T. 8 R. 6
3 miles east of Waynesboro
(distance) (direction) (Nearest Town)

(3) Topography: flat
(Hilly) (Flat) (Level)

(4) Purpose of Well: domestic
(Domestic Irrigation
Municipal, Industrial, Other)

Description & Color of Materials Sand, Clay, Red Clay, Shell, etc.	Thick- ness Feet	Depth Feet
<u>red clay</u>	<u>8</u>	<u>8</u>
<u>sand</u>	<u>7</u>	<u>15</u>
<u>blue chalk</u>	<u>30</u>	<u>45</u>
<u>rock</u>	<u>3</u>	<u>48</u>
<u>chalk</u>	<u>1</u>	<u>49</u>
<u>rock</u>	<u>5</u>	<u>54</u>
<u>blue chalk</u>	<u>50</u>	<u>104</u>
<u>longeone rock</u>		
<u>Vicksburg</u>	<u>28</u>	<u>132</u>

Information upon completion of well:

(1) Diameter 2" inches.

(2) Total Depth 132 feet.

(3) Water Level 30' feet below top of ground.

(4) Cased to 105', Size 2"


(5) Screen: Size none Length _____

(6) Were any formations sealed against pollution?
_____ yes, X no.

If YES depth of formation _____

Why _____

Drillers Remarks: _____

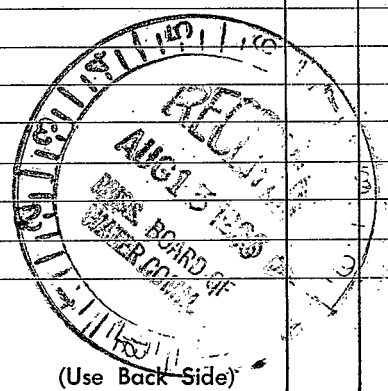

(Use Back Side)

Well No.

