

WAYNE

047

7-17-65

MISSISSIPPI BOARD OF WATER COMMISSIONERS

WATER WELL DRILLERS LOG

Date: July 17, 1965, Driller: Porter Drilling & Pump Co. County: Wayne
James D. Stone well (Name)

(1) Owner of Land: Raymond Clark
(Name)
Waynesboro Miss.
(Address)

(2) Location: NW 1/4, NW 1/4, Sec 10 T 8 R 6
(distance) (direction) (Nearest Town)

4 miles east of Waynesboro
(distance) (direction) (Nearest Town)

(3) Topography: hilly
(Hilly) (Flat) (Level)

(4) Purpose of Well: domestic
(Domestic Irrigation
Municipal, Industrial, Other)

Description & Color of Materials Sand, Clay, Red Clay, Shell, etc.	Thick- ness Feet	Depth Feet
red clay	12	12
sand + chalk	24	36
med clean sand	3	39
sand + chalk	21	60
sand with a little chalk	6	66
Chalk	3	69

Information upon completion of well:

(1) Diameter 2" inches.

(2) Total Depth 66' feet.

(3) Water Level 23' feet below top of ground.

(4) Cased to 61', Size 2"


(5) Screen: Size 1 1/4", Length 5'
8 slot Johnson S.S. screwed patent on casing?

(6) Were any formations sealed against pollution?
_____ yes, X no.

If YES depth of formation _____

Why _____

Drillers Remarks: _____

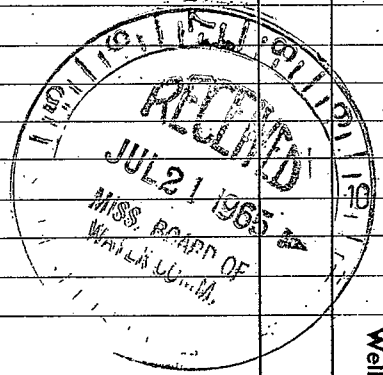

Well No.

(Use Back Side)

