

Wayne  
049  
10-66

MISSISSIPPI BOARD OF WATER COMMISSIONERS

WATER WELL DRILLERS LOG

Date Oct 31, 1966, Driller Porter Drilling & Sup County Wayne  
(Name)


(1) Owner of Land: Lawrence Taylor  
(Name)  
At 4 Waynesboro, Miss  
(Address)  
(2) Location: NW 1/4, SE 1/4, Sec. 10 T9 R6  
1/2 miles east of Waynesboro  
(distance) (direction) (Nearest Town)  
(3) Topography: Hilly  
(Hilly) (Flat) (Level)  
(4) Purpose of Well: domestic  
(Domestic Irrigation  
Municipal, Industrial, Other)

Description & Color of Materials Sand, Clay, Red Clay, Shell, etc.	Thick- ness Feet	Depth Feet
<u>red clay</u>	<u>5</u>	<u>5</u>
<u>Chalk</u>	<u>6</u>	<u>11</u>
<u>sand &amp; chalk</u>	<u>22</u>	<u>33</u>
<u>med coarse sand</u>	<u>25</u>	<u>58</u>
<u>Chalk &amp; sand</u>	<u>22</u>	<u>80</u>
<u>med clean sand</u>	<u>11</u>	<u>91</u>
<u>stagnant white silty in sand</u>		

Information upon completion of well:

(1) Diameter 2" inches.  
(2) Total Depth 91' feet.  
(3) Water Level 54 feet below top of ground.  
(4) Cased to 84', Size 2"  
(5) Screen: Size 1 1/4", Length 5'  
Johanson 8 slot S.S.  
with 3' lip tight in with packer  
(6) Were any formations sealed against pollution?  
no

If YES depth of formation \_\_\_\_\_  
Why \_\_\_\_\_  
Drillers Remarks: \_\_\_\_\_

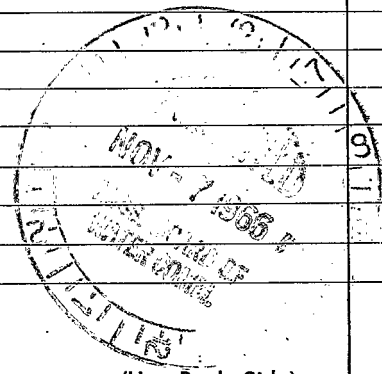

(Use Back Side)

Well No.

