

WAYNE

MISSISSIPPI BOARD OF WATER COMMISSIONERS

050

7-12-62

WATER WELL DRILLERS LOG

Date: July 12, 1962 Driller: Porter Drilling & Log County: Wayne
(Name)

(1) Owner of Land:	Description & Color of Materials Sand, Clay, Red Clay, Shell, etc.	Thick- ness Feet	Depth Feet
Bill Ross (Name)	red clay	10	10
Rt 2 Waynesboro (Address)	chalk	10	20
SE 1/4, NW 1/4, Sec. 10 T. 8 R. 6, 4 miles east of Waynesboro (distance) (direction) (Nearest Town)	sand mixed chalk stayed white still in sand	26	46
(2) Location:			
(3) Topography: hilly (Hilly) (Fig) (Level)			
(4) Purpose of Well: domestic (Domestic Irrigation Municipal, Industrial, Other)			

Information upon completion of well:


- (1) Diameter 2" inches.
- (2) Total Depth 46' feet.
- (3) Water Level 16' feet below top of ground.
- (4) Cased to 40, Size 2"
- (5) Screen: Size 1 1/4, Length 6'
- (6) Were any formations sealed against pollution?

yes, no.

If YES depth of formation _____

Why _____

Drillers Remarks: _____

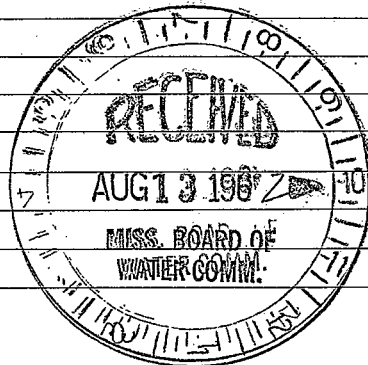

(Use Back Side)

Well No.

