

O 55
6-15-64

WATER WELL DRILLERS LOG

Date June 15, 1964, Driller Porter Drilling & Pump Co. Wayne
(Name)

(1) Owner of Land: M. B. Busby
(Name)
212 N. Magnolia, Miss.
(Address)

(2) Location: NW 1/4, NE 1/4, Sec. 13 T8 R6
6 miles east, of Waynesboro
(distance) (direction) (Nearest Town)

(3) Topography: hilly
(Hilly) (Flat) (Level)

(4) Purpose of Well: domestic
(Domestic Irrigation
Municipal, Industrial, Other)

Description & Color of Materials Sand, Clay, Red Clay, Shell, etc.	Thick- ness Feet	Depth Feet
<u>red clay</u>	<u>15</u>	<u>15</u>
<u>fine sand</u>	<u>10</u>	<u>25</u>
<u>sand to chalk</u>	<u>15</u>	<u>40</u>
<u>med to coarse sand</u>	<u>20</u>	<u>60</u>
<u>coarse red sand</u>	<u>10</u>	<u>70</u>
<u>med white sand</u>	<u>8</u>	<u>78</u>
<u>stopped on rock</u>		

Information upon completion of well:

(1) Diameter 2" inches.

(2) Total Depth 78' feet.

(3) Water Level 48' feet below top of ground.


(4) Cased to 72', Size 2"

(5) Screen: Size 1 1/4", Length 5'
Johnson S.S.

(6) Were any formations sealed against pollution?
no

If YES depth of formation _____
Why _____

Drillers Remarks: _____

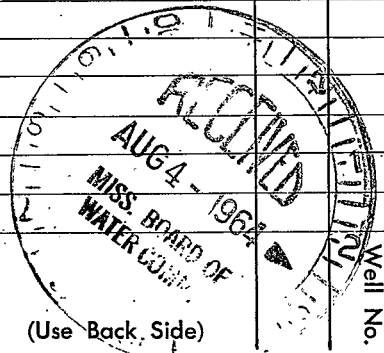

(Use Back Side)

