

Wayne
060
3-67

MISSISSIPPI
BOARD OF WATER COMMISSIONERS
416 North State Street
Jackson, Mississippi 39201

WATER WELL DRILLERS LOG

March 11 1967 Porter Drilling Co. Wayne
date well completed firm name county well located

LANDOWNER: Reynolds Clark
Station 11
Waynesboro, Miss
Sullivan home
(mailing address)

WELL LOCATION:
sec. 18 T 2 N R 6 E
S W
1 miles SE of Waynesboro
(distance) (direction) (nearest town)

WELL PURPOSE: home
(home, irrigation, municipal, industrial)


WELL COMPLETION DATA:

- (1) diameter (inches) 2"
- (2) total depth (feet) 103
- (3) static water level (feet) 39 below above top of ground.
- (4) casing galv. steel 96'
(material) (depth)
2"
(size) if telescope see back.
- (5) screen 6' 97
(length) (depth to top)
1/4" brass jacket
(size) (material)
- (6) pump 3/4 8
(HP) (yield gpm)
elec.
(type power)
- (7) electric log no
(yes or no)

(organization running log)
- (8) how well bottom plugged
flush point

description of formations encountered	from	to
<u>red clay</u>	<u>0</u>	<u>10</u>
<u>sand</u>	<u>10</u>	<u>20</u>
<u>blue chalk</u>	<u>20</u>	<u>33</u>
<u>rock strata</u>	<u>33</u>	<u>37</u>
<u>blue chalk</u>	<u>37</u>	<u>65</u>
<u>rock strata</u>	<u>65</u>	<u>79</u>
<u>blue chalk</u>	<u>79</u>	<u>80</u>
<u>sand</u>	<u>80</u>	<u>103</u>
<u>stayed white</u>		
<u>still in sand</u>		

DRILLERS REMARKS:

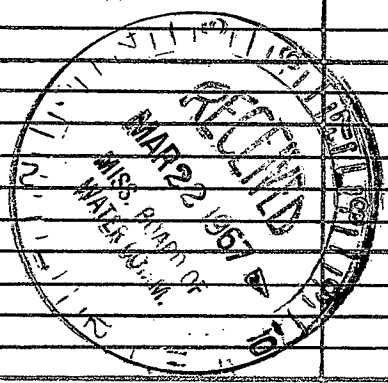

If well telescopes please sketch and show depths.

GROUND LEVEL

			X

SECTION 18

Please indicate well location X.

ADDITIONAL INFORMATION

If more than one screen, show locations of each on sketch.