

062

4-14-64

WATER WELL DRILLERS LOG

Date: April 14, 1964, Driller: Porter Dilling Wayne County Wayne  
 (Name)

(1) Owner of Land: Raymond Clark  
 (Name)  
Waynesboro Miss  
 (Address)

(2) Location: NE 1/4, SE 1/4, Sec. 18 T8R6,  
1 miles S E of Waynesboro,  
 (distance) (direction) (Nearest Town)

(3) Topography: flat  
 (Hilly) (Flat) (Level)

(4) Purpose of Well: domestic  
 (Domestic Irrigation  
 Municipal, Industrial, Other)

Description & Color of Materials Sand, Clay, Red Clay, Shell, etc.	Thick- ness Feet	Depth Feet
<u>chalk</u>	<u>10</u>	<u>10</u>
<u>sand</u>	<u>4</u>	<u>14</u>
<u>blue chalk</u>	<u>11</u>	<u>25</u>
<u>rock</u>	<u>1</u>	<u>26</u>
<u>blue chalk</u>	<u>5</u>	<u>31</u>
<u>rock</u>	<u>1</u>	<u>32</u>
<u>blue chalk</u>	<u>19</u>	<u>51</u>
<u>strata of rock</u>	<u>19</u>	<u>70</u>
<u>blue chalk</u>	<u>2</u>	<u>72</u>
<u>fine blue sand</u>	<u>16</u>	<u>88</u>
<u>stopped white</u>		
<u>still in sand</u>		

Information upon completion of well:

(1) Diameter 2" inches.

(2) Total Depth 88' feet.

(3) Water Level 28' feet below top of ground.

(4) Cased to 82', Size 2"


(5) Screen: Size 1 1/4", Length 6'  
80 ga

(6) Were any formations sealed against pollution?  
yes, X no.

If YES depth of formation \_\_\_\_\_

Why \_\_\_\_\_

Drillers Remarks: \_\_\_\_\_

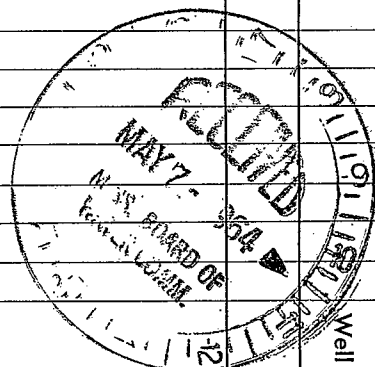

(Use Back Side)

Well No.

