

WAYNE MISSISSIPPI BOARD OF WATER COMMISSIONERS

065

4-20-65 WATER WELL DRILLERS LOG

Date April 20, 1965, Driller Porter Drilling & Log County Wayne
 (Name)


(1) Owner of Land Jack Gray Love
Raymond Clark
 (Name)
Rt 4 Waynesboro
 (Address)
 (2) Location: SW 1/4, NE 1/4, Sec. 18 T8 R6
1 miles SE of Waynesboro
 (distance) (direction) (Nearest Town)
 (3) Topography: flat
 (Hilly) (Flat) (Level)
 (4) Purpose of Well: domestic
 (Domestic Irrigation
 Municipal, Industrial, Other)

Description & Color of Materials Sand, Clay, Red Clay, Shell, etc.	Thick- ness Feet	Depth Feet
<u>red clay</u>	<u>5</u>	<u>5</u>
<u>white sand</u>	<u>12</u>	<u>17</u>
<u>blue chalk</u>	<u>4</u>	<u>21</u>
<u>rock strata</u>	<u>12</u>	<u>33</u>
<u>blue chalk</u>	<u>13</u>	<u>46</u>
<u>soft rock</u>	<u>2</u>	<u>48</u>
<u>grey sand</u>	<u>4</u>	<u>52</u>
<u>rock strata</u>	<u>14</u>	<u>66</u>
<u>chalk</u>	<u>2</u>	<u>68</u>
<u>fine grey sand</u>	<u>16</u>	<u>84</u>
<u>stopped white</u>		
<u>still in sand</u>		

Information upon completion of well:

(1) Diameter 2" inches.
 (2) Total Depth 84' feet.
 (3) Water Level 23' feet below top of ground.
 (4) Cased to 78', Size 2"
 (5) Screen: Size 1/4", Length 6'
80 ga
 (6) Were any formations sealed against pollution?
 _____ yes, X no.

If YES depth of formation _____
 Why _____
 Drillers Remarks: _____

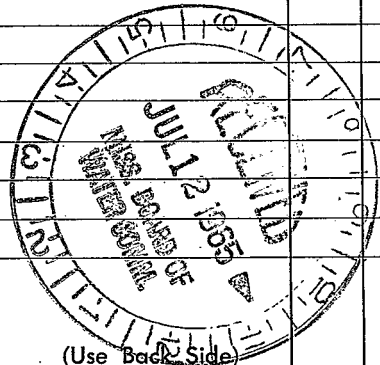

(Use Back Side)

Well No. _____

