

Wayne  
069  
3-67

MISSISSIPPI  
BOARD OF WATER COMMISSIONERS  
416 North State Street  
Jackson, Mississippi 39201

WATER WELL DRILLERS LOG

March 2 1967 Porter Drilling Shop Wayne  
date well completed firm name county well located

LANDOWNER: Th. J. Wells

description of formations encountered

from to

Waynesboro Miss

red clay

0 8

Easthill Sub. No 1  
(mailing address)

white chalk

209 20

WELL LOCATION:

sand

20 34

sec. 18 T. 8 N. R. 6 E  
S W  
1 miles S.E. of Waynesboro  
(distance) (direction) (nearest town)

chalk

34 36

WELL PURPOSE: home  
(home, irrigation, municipal, industrial)

sand & chalk

36 76

WELL COMPLETION DATA:

red chalk

76 90

(1) diameter (inches) 2"

blue chalk & sand streaks

80 95

(2) total depth (feet) 160

blue chalk

95 115

(3) static water level (feet) 103 below  
top of ground.

soft thin rocks

115 116

(4) casing gal. steel, 150'  
(material) (depth)

blue chalk

116 123

2"  
(size) if telescope see back.

sand with chalk streak

123 127

(5) screen 12', 148  
(length) (depth to top)

sturgeon chalk

127 145

1 1/4, brass jacket  
(size) (material)

(6) pump 1 1/2, 6  
(HP) (yield gpm)


elec.  
(type power)

(7) electric log no  
(yes or no)

(organization running log)


(8) how well bottom plugged  
flush joint

DRILLERS REMARKS:

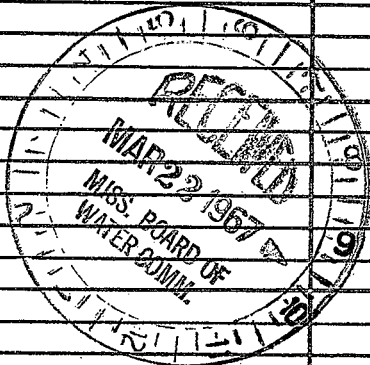

If well telescopes please sketch and show depths.

GROUND LEVEL

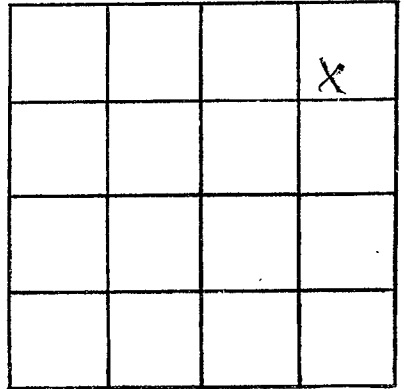

SECTION 18

Please indicate well location X.

ADDITIONAL INFORMATION

If more than one screen, show locations of each on sketch.