

Wayne
071
9-67

MISSISSIPPI
BOARD OF WATER COMMISSIONERS
416 North State Street
Jackson, Mississippi 39201

WATER WELL DRILLERS LOG

SEPT 19 07 PEEPLES DRILLING CO WAYNE
date well completed firm name county well located

LANDOWNER: JOSEPHINE OAKLEY

RT 4

WAYNES BORO, MISS
(mailing address)

WELL LOCATION:

sec. 21 T. 8 N R. 6 E
S W
2 1/2 miles SE of WARD
(distance) (direction) (nearest town)

WELL PURPOSE: HOME
(home, irrigation, municipal, industrial)

WELL COMPLETION DATA:

- (1) diameter (inches) 2
- (2) total depth (feet) 48
- (3) static water level (feet) 35 ^{below} _{above} top of ground.
- (4) casing GALV, 42
(material) (depth)
2 (size) if telescope see back.
- (5) screen 6' 42'
(length) (depth to top)
2" BRASS
(size) (material)
- (6) pump 1/2 3
(HP) (yield gpm)
ELECT
(type power)
- (7) electric log NO
(yes or no)
(organization running log)
- (8) how well bottom plugged BACK
WASH VALVE


description of formations encountered

from

to

YELLOW SANDY CLAY & SAND STREAKS 0 34

YELLOW SAND 34 48

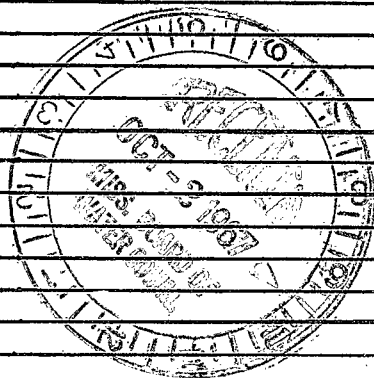

DRILLERS REMARKS:

If well telescopes please sketch and show depths.

GROUND LEVEL

X			

SECTION 21
~~33~~

Please indicate well location X.

ADDITIONAL INFORMATION

If more than one screen,
show locations of each on sketch.