

Wayne  
073  
10-67

MISSISSIPPI  
BOARD OF WATER COMMISSIONERS  
416 North State Street  
Jackson, Mississippi 39201

WATER WELL DRILLERS LOG

Oct 1967 Peoples Drilling Co Wayne  
date well completed firm name county/well located

LANDOWNER: Omega Stone  
Rt 4 Waynesboro, Miss  
(mailing address)

description of formations encountered	from	to
yellow clay	0	19
yellow sand + sandy clay	19	42
white clay	42	60
yellow sand to pea gravel	60	90


WELL LOCATION:  
sec 24 T. 3 N. R. 10 E. W. 4  
4 miles E of WABO.  
(distance) (direction) (nearest town)

WELL PURPOSE: Home  
(home, irrigation, municipal, industrial)

WELL COMPLETION DATA:


- (1) diameter (inches) 2
- (2) total depth (feet) 90
- (3) static water level (feet) 65 <sup>below</sup> <sub>above</sub> top of ground.
- (4) casing Gels. 94  
(material) (depth)  
2 if telescope see back.  
(size)
- (5) screen 6' 84'  
(length) (depth to top)  
7" Brass  
(size) (material)
- (6) pump 1/2 3  
(HP) (yield gpm)  
Elect  
(type power)
- (7) electric log No  
(yes or no)  
(organization running log)
- (8) how well bottom plugged Back  
Wash Water

DRILLERS REMARKS:

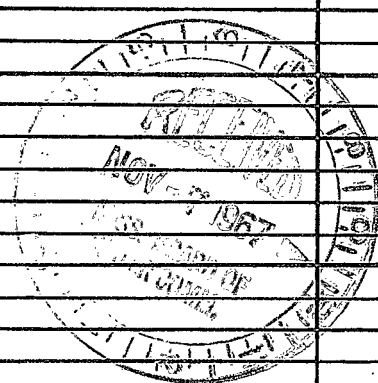

If well telescopes please sketch and show depths.

GROUND LEVEL

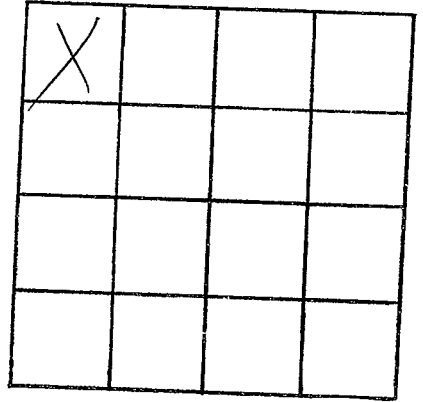

SECTION 24

Please indicate well location X.

ADDITIONAL INFORMATION

If more than one screen,  
show locations of each on sketch.