

MISSISSIPPI
BOARD OF WATER COMMISSIONERS
416 North State Street
Jackson, Mississippi 39201

WATER WELL DRILLERS LOG

Wayne
075
9-67

SEPT 19 67 Peoples Drilling Co Wayne
date well completed firm name county well located

LANDOWNER: LEMON SMITH

RT4

WAYNES BORO
(mailing address)

WELL LOCATION:

sec. 27 T. 8 N R. 6 E
4 miles SE of WABO
(distance) (direction) (nearest town)

WELL PURPOSE: HOME
(home, irrigation, municipal, industrial)

WELL COMPLETION DATA:

- (1) diameter (inches) 2"
- (2) total depth (feet) 132'
- (3) static water level (feet) 90' below above top of ground.
- (4) casing GALV , 120'
(material) (depth)
2" if telescope see back.
(size)
- (5) screen 6', 120'
(length) (depth to top)
2", BRASS
(size) (material)
- (6) pump 1 8
(HP) (yield gpm)
- FLECT
(type power)
- (7) electric log NO
(yes or no)
- (organization running log)

(8) how well bottom plugged BACK WASH VALVE


description of formations encountered	from	to
<u>YELLOW SANDY CLAY</u>	<u>0</u>	<u>18</u>
<u>YELLOW SANDY CLAY & SAND STREAKS</u>	<u>18</u>	<u>42</u>
<u>WHITE CLAY & SAND STREAKS</u>	<u>42</u>	<u>115</u>
<u>WHITE SAND</u>	<u>115</u>	<u>132</u>



DRILLERS REMARKS:

If well telescopes please sketch and show depths.

GROUND LEVEL

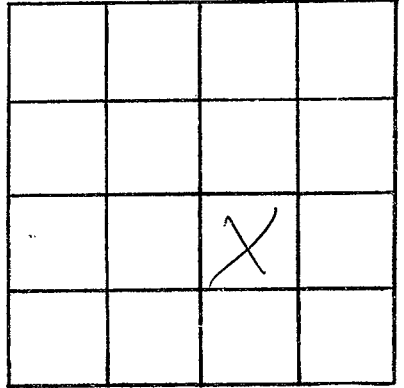

SECTION 27

Please indicate well location X.

ADDITIONAL INFORMATION

If more than one screen,
show locations of each on sketch.