

**MISSISSIPPI
BOARD OF WATER COMMISSIONERS**
416 North State Street
Jackson, Mississippi 39201

WATER WELL DRILLERS LOG

Wayne
07
3-67

March 31 1967 Porter Drilling Co. Wayne
date well completed firm name county well located

LANDOWNER: <u>Lester Holcomb</u>	description of formations encountered	from	to
<u>At 4 Waynesboro, Miss</u>			
<u>red clay</u>		<u>0</u>	<u>10</u>
<u>sand</u>		<u>10</u>	<u>34</u>
<u>chalk</u>		<u>34</u>	<u>52</u>
<u>fine red sand</u>		<u>52</u>	<u>70</u>
<u>loam red sand</u>		<u>70</u>	<u>79</u>
<u>white loam sand</u>		<u>79</u>	<u>84</u>
<u>stop on chalk</u>			

WELL LOCATION:
sec 28 T 8 N R 6 E
S W
4 miles SE of Waynesboro
(distance) (direction) (nearest town)


WELL PURPOSE: home
(home, irrigation, municipal, industrial)

WELL COMPLETION DATA:

- (1) diameter (inches) 2
- (2) total depth (feet) 84
- (3) static water level (feet) 42 below above top of ground.
- (4) casing steel, 79'
(material) (depth)
2" if telescope see back.
(size)
- (5) screen 5', 79'
(length) (depth to top)
1/4, Johnson SS, 7 slot
(size) (material)
- (6) pump 1, 8
(HP) (yield gpm)
elec.
(type power)
- (7) electric log no
(yes or no)
(organization running log)

(8) how well bottom plugged plug point

DRILLERS REMARKS:

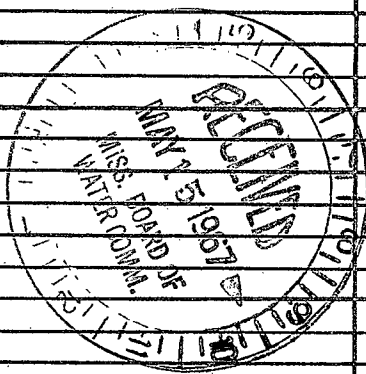

If well telescopes please sketch and show depths.

GROUND LEVEL

			X

SECTION 28

Please indicate well location X.

ADDITIONAL INFORMATION

If more than one screen,
show locations of each on sketch.