

WAYNE
078
11-65

MISSISSIPPI BOARD OF WATER COMMISSIONERS

WATER WELL DRILLERS LOG

CODED

Date: Nov., 1965, Driller: Peeples Drilling Co County Wayne
(Name)

253/4

(1) Owner of Land: S.C. Hill

(Name)

Rt 4 Box 48 Waynesboro

(Address)

(2) Location: 1/4, 1/4, Sec. 21 T. 8. R. 6

3 miles SE of Waynesboro
(distance) (direction) (Nearest Town)

(3) Topography: Hilly
(Hilly) (Flat) (Level)

(4) Purpose of Well: Home
(Domestic Irrigation
Municipal, Industrial, Other)

Description & Color of Materials
Sand, Clay, Red Clay, Shell, etc.

Thick-
ness
Feet

Depth
Feet

White sand 18 18

yellow clay 15 33

yellow sand

clay shell 42 75

Information upon completion of well:

(1) Diameter 2 inches.

(2) Total Depth 75 feet.

(3) Water Level 55 feet below top of ground.

(4) Cased to 69', Size 2"

(5) Screen: Size 2", Length 4'

(6) Were any formations sealed against pollution?


 yes, no.

If YES depth of formation

Why

Drillers Remarks:

CODED

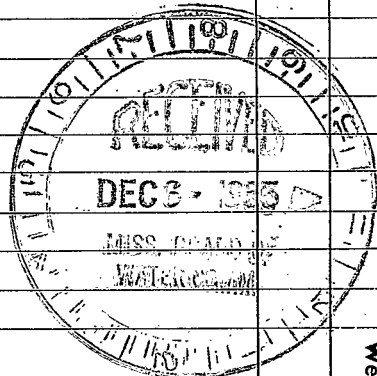

(Use Back Side)

Well No.

