

Wayne
079
4-67

MISSISSIPPI
BOARD OF WATER COMMISSIONERS
416 North State Street
Jackson, Mississippi 39201

WATER WELL DRILLERS LOG

April 19, 1967 Porter Drilling & Sup Wayne
date well completed firm name county well located


LANDOWNER: Winchester
Cemetery Assn.
Box 4 Waynesboro Miss
(mailing address)
WELL LOCATION:
sec. 33 T. 8 N. R. 6 E.
S. W.
miles of Winchester
(distance) (direction) (nearest town)

description of formations encountered	from	to
	<u>sand</u>	<u>0</u>
<u>chalk</u>	<u>6</u>	<u>14</u>
<u>fine sand</u>	<u>14</u>	<u>23</u>
<u>sand & per gravel</u>	<u>23</u>	<u>30</u>
<u>stayed inside steel</u>		
<u>to sand</u>		

WELL PURPOSE: church
(home, irrigation, municipal, industrial)


WELL COMPLETION DATA:
(1) diameter (inches) 1 1/4"
(2) total depth (feet) 29
(3) static water level (feet) 21 below above top of ground.
(4) casing Copper, 26,
(material) (depth)
1/4 If telescope see back.
(size)
(5) screen 3', 26
(length) (depth to top)
1/4, Johnson S.S.
(size) (material)
(6) pump 1/2, 6
(HP) (yield gpm)
elec
(type power)
(7) electric log no
(yes or no)
(organization running log)
(8) how well bottom plugged
flush gravel

DRILLERS REMARKS:

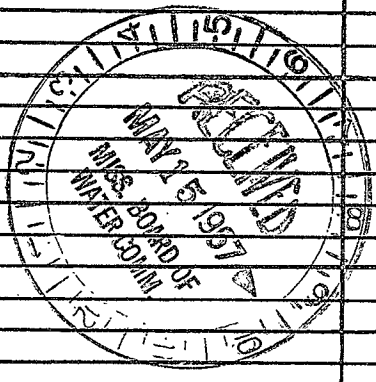

If well telescopes please sketch and show depths.

GROUND LEVEL

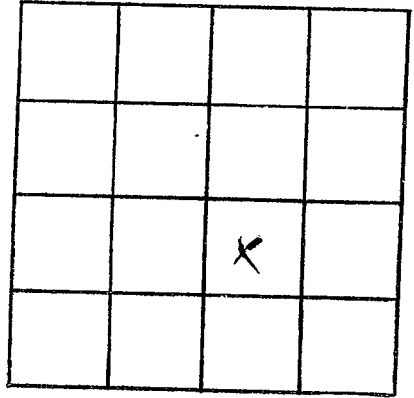

SECTION 33

Please indicate well location X.

ADDITIONAL INFORMATION

If more than one screen,
show locations of each on sketch.