

WAYNE MISSISSIPPI BOARD OF WATER COMMISSIONERS

080

12-6-62

WATER WELL DRILLERS LOG

Date: Dec 6, 1962, Driller: Porter Drilling & Log Co. Wayne (Name)

(1) Owner of Land: Bill Roman (Name)

Atty. Waynesboro, Miss (Address)

(2) Location: SE 1/4, NE 1/4, Sec. 34, T. 8 R. 6, 6 miles SE of Waynesboro (distance, direction, Nearest Town)

(3) Topography: hilly (Hilly, Flat, Level)

(4) Purpose of Well: domestic (Domestic Irrigation, Municipal, Industrial, Other)

Table with 3 columns: Description & Color of Materials, Thickness Feet, Depth Feet. Rows include: red clay (12' 12'), sand (4' 16'), white chalk (23' 39'), coarse dry sand (10' 49'), chalk & sand (21' 70'), fractured sand (14' 84'), coarse sand (10' 94').

Information upon completion of well:

(1) Diameter: 2 inches.

(2) Total Depth: 94 feet.

(3) Water Level: 53 feet below top of ground.

(4) Cased to: 28, Size: 2"


(5) Screen: Size: 1 1/4, Length: 6'

(6) Were any formations sealed against pollution? yes, X no.

If YES depth of formation

Why

Drillers Remarks:

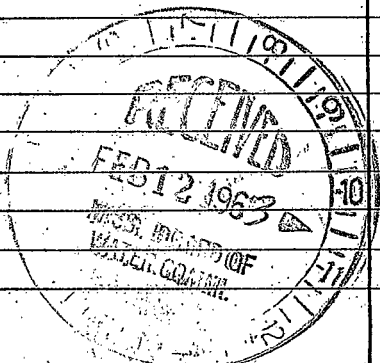

(Use Back Side)

Well No.

