

Wayne
084

MISSISSIPPI BOARD OF WATER COMMISSIONERS

7-66

WATER WELL DRILLERS LOG

CODED

Date: July, 1966, Driller: Peoples Drilling Co County Wayne
 471/19? (Name)

(1) Owner of Land: Bob McCall
 (Name)

RFD Waynesboro, Miss
 (Address)
 12 8 6

(2) Location: 1/4, 1/4, Sec. 26 T10R8
5 miles E of Waynesboro
 (distance) (direction) (Nearst Town)

(3) Topography: Hilly
 (Hilly) (Flat) (Level)

(4) Purpose of Well: Home & Chicken Farm
 (Domestic Irrigation Municipal, Industrial, Other)

Description & Color of Materials Sand, Clay, Red Clay, Shell, etc.	Thick- ness Feet	Depth Feet
Yellow Sandy clay	15	15
Yellow Sand	23	38
White Clay	12	50
White Sand	40	90

CODED

Information upon completion of well:

(1) Diameter 2 inches.

(2) Total Depth 90 feet.

(3) Water Level 42 feet below top of ground.

(4) Cased to 84', Size 2"


(5) Screen: Size 2", Length 6'

(6) Were any formations sealed against pollution?
 yes, no.

If YES depth of formation _____

Why _____

Drillers Remarks: _____

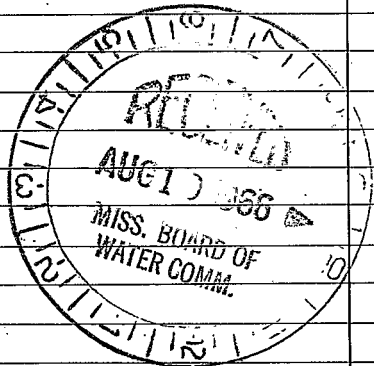

Well No.

(Use Back Side)

