

Wayne  
087  
3-68

MISSISSIPPI  
BOARD OF WATER COMMISSIONERS  
416 North State Street  
Jackson, Mississippi 39201

WATER WELL DRILLERS LOG

March 2 1968 Porte Drilling & Equip Wayne  
date well completed firm name county well located

LANDOWNER: S. J. Whitney  
At 4 Waynesboro, Miss  
(mailing address)


description of formations encountered	from	to
red clay	0	15
sand & chalk	15	25
Chalk	25	45
sand	45	52
Chalk	52	65
med to red coarse sand	65	71
stoped on chalk		

WELL LOCATION:  
sec. 11 T 2 N R 6 E  
5 miles east of Waynesboro  
(distance) (direction) (nearest town)

WELL PURPOSE: Home  
(home, irrigation, municipal, industrial)

- WELL COMPLETION DATA:
- (1) diameter (inches) 2"
  - (2) total depth (feet) 71'
  - (3) static water level (feet) 47' below above top of ground.
  - (4) casing steel, 66',  
(material) (depth)  
2" if telescope see back.  
(size)
  - (5) screen 6', 65'  
(length) (depth to top)
  - 1/4", plastic 2 slots  
(size) (material)
  - (6) pump 3/4, 7  
(HP) (yield gpm)
  - elec  
(type power)
  - (7) electric log no  
(yes or no)
  - (organization running log)
  - (8) how well bottom plugged flush screen

DRILLERS REMARKS:

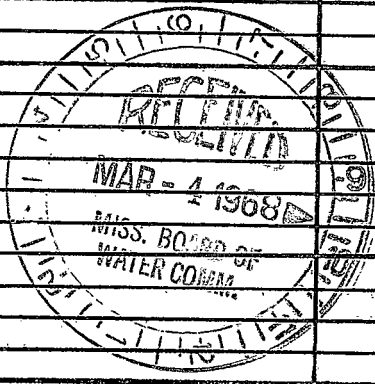

If well telescopes please sketch and show depths.

GROUND LEVEL

			X

SECTION 11

Please indicate well location X.

ADDITIONAL INFORMATION

If more than one screen,  
show locations of each on sketch.