

WAYNE
088
3-68

MISSISSIPPI
BOARD OF WATER COMMISSIONERS
416 North State Street
Jackson, Mississippi 39201

WATER WELL DRILLERS LOG

March 29 1968 Boote Drilling Co. Wayne
date well completed firm name county well located

LANDOWNER: Wayne Clark
Ad. Est. Station St.
Waynesboro Miss.
(mailing address)

WELL LOCATION:
sec. 18 T. 8 (N) R. 6 (E)
1 miles SE of Waynesboro
(distance) (direction) (nearest town)

WELL PURPOSE: home
(home, irrigation, municipal, industrial)

- WELL COMPLETION DATA:
- (1) diameter (inches) 2"
 - (2) total depth (feet) 97'
 - (3) static water level (feet) 49 below above top of ground.
 - (4) casing steel, 91'
(material) (depth)
2' If telescope see back.
(size)
 - (5) screen 6', 91'
(length) (depth to top)
1/4", 80 gae. brass jacket
(size) (material)
 - (6) pump 3/4, 7
(HP) (yield gpm)
elec.
(type power)
 - (7) electric log no
(yes or no)

(organization running log)

(8) how well bottom plugged
flush joint

description of formations encountered	from	to
<u>red clay</u>	<u>0</u>	<u>13</u>
<u>sand</u>	<u>13</u>	<u>28</u>
<u>chalk</u>	<u>28</u>	<u>43</u>
<u>rock strata</u>	<u>43</u>	<u>51</u>
<u>blue chalk</u>	<u>51</u>	<u>67</u>
<u>rock strata</u>	<u>67</u>	<u>86</u>
<u>blue chalk</u>	<u>86</u>	<u>88</u>
<u>med fine sand</u>	<u>88</u>	<u>97</u>
<u>stagnant on chalk</u>		


APR 26 1968

MISS. BD. OF
WATER COMM.

DRILLERS REMARKS:

If well telescopes please sketch and show depths.

GROUND LEVEL

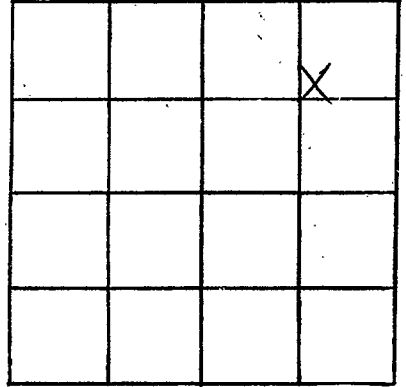

SECTION 18

Please indicate well location X.

ADDITIONAL INFORMATION

If more than one screen,
show locations of each on sketch.