

WAYNE
089
3-68

MISSISSIPPI
BOARD OF WATER COMMISSIONERS
416 North State Street
Jackson, Mississippi 39201

WATER WELL DRILLERS LOG

March 29 1968 Porter Drilling & Log Wayne
date well completed firm name county well located

LANDOWNER: Mack Green

description of formations encountered

from to

Qtz 4

Waynesboro Miss.
(mailing address)

<u>rest clay</u>	0	8
<u>white chalk</u>	8	16
<u>sand & chalk</u>	16	42
<u>loose sand</u>	42	80
<u>clean sand</u>	80	91
<u>stopped on rock</u>		

WELL LOCATION:

sec 24 T 8 N 3 R 6 E 7 W
52 miles east of Waynesboro
(distance) (direction) (nearest town)

WELL PURPOSE: home
(home, irrigation, municipal, industrial)

WELL COMPLETION DATA:

- (1) diameter (inches) 2"
- (2) total depth (feet) 91
- (3) static water level (feet) 56' below top of ground.
- (4) casing steel, 84'
(material) (depth)
2" if telescope see back.
(size)
- (5) screen 5', 86'
(length) (depth to top)
1/4", galv Johnson S.S.
(size) (material)
- (6) pump 3/4, 7
(HP) (yield gpm)
elec
(type power)
- (7) electric log no
(yes or no)

(organization running log)

(8) how well bottom plugged flush point


DRILLERS REMARKS:

APR 26 1968

MISS. BD. OF
WATER COMMISSIONERS

If well telescopes please sketch and show depths.

GROUND LEVEL

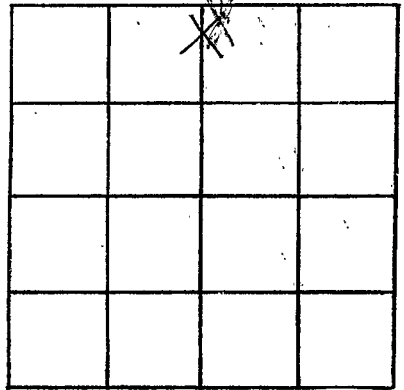

SECTION 24

Please indicate well location X.

ADDITIONAL INFORMATION

If more than one screen, show locations of each on sketch.