

31°38'25" 80 35'13

WAYNE
090
4-68

MISSISSIPPI
BOARD OF WATER COMMISSIONERS
416 North State Street
Jackson, Mississippi 39201

WATER WELL DRILLERS LOG

April 30 1968 Bohrer Drilling Co. Wayne
date well completed firm name county well located

LANDOWNER: Doyle Palmer

description of formations encountered from to

Box 4 Waynesboro Miss
(mailing address)

red clay 0 10
red sand to some gravel 10 35
clean medium sand 35 53
med fine sand & some chalk med 53 73
stagnant white silty
no fine loose red sand

WELL LOCATION:
sec 21 T 8 N R 6 E
3 miles SE of Waynesboro
(distance) (direction) (nearest town)

WELL PURPOSE: home
(home, irrigation, municipal, industrial)


WELL COMPLETION DATA:

- (1) diameter (inches) 2'
- (2) total depth (feet) 53'
- (3) static water level (feet) 32 below top of ground.
- (4) casing steel, 48'
(material) (depth)
2' if telescope see back.
(size)
- (5) screen 5' 48'
(length) (depth to top)
1/4" Galot Johnson S.S.
(size) (material)
- (6) pump 2 8
(HP) (yield gpm)
elec.
(type power)
- (7) electric log no
(yes or no)

(organization running log)


(8) how well bottom plugged flush point

DRILLERS REMARKS:

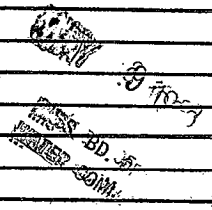

If well telescopes please sketch and show depths.

GROUND LEVEL

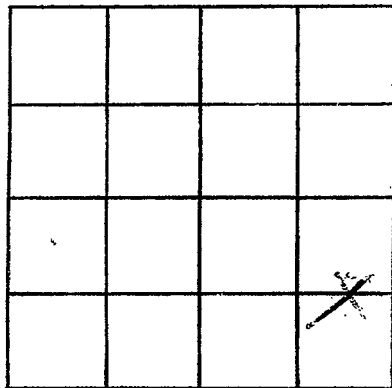

SECTION 21

Please indicate well location X:

ADDITIONAL INFORMATION

If more than one screen,
show locations of each on sketch.